

JAN 31 2001

LAND CORNER RECORDATION CERTIFICATE
Filing Requirement of Act 74, Mich. P.A. 1970

STATE OF MICHIGAN
COUNTY OF MUSKEGON
RECEIVED FOR RECORD

200 DEC 21 PM 12: 56

For corner SECTION

Muskegon (County) Located In: Corner Code #
1. Public Land Survey T10N R14W E-9
2. Property Controlling in Section S T R
3. Miscellaneous Property in Sec. S T R

Mark Fairchild
REGISTER OF DEEDS

Register of Deeds Stamp & File Number

4. Lot No. , Recorded Plat
5. Private Claims

I, Stephen V. Vallier, in a field survey on October 31, 2000 do hereby state that under requirements of P.A. 74, Michigan P.A. of 1970, the corner points mentioned in lines 1 and 2 above were in conformance with regulations and rules therefore as required in the current manual of survey instructions of the United States Department of the Interior, Bureau of Land Management or by a decree of a Court of Law and /or that the corner points mentioned in lines 3, 4 and 5 above were in conformance with the rules of the Michigan Board of Land Surveyors or by a Decree of a Court of Law; established, re-established, monumented, recovered, found as expressed below:

Grid table with columns A-M and rows 1-13. A dot is marked at the intersection of column E and row 9.

NOTE: Not more than 2 corners, all in the same town and range, may be recorded on this certificate.

A. Description of original monument and accessories and/or subsequent restoration:

- 1837 John Mullett (G.L.O.) set post. 8" Beech for Corner N 10° E 20" Pine 19Links
1950's Muskegon County road Commission's witness sheet notes no description of corner. NW 94.45' Power Pole ESE 64.23' Telephone Pole SW 98.45' NE Corner of House
1955 Plat of Moorland Acres recorded in Liber 12 of Plats, Page 48. SE corner of plat is E-9.
1961 Michigan Department of Transportation shows corner in Right-of-way Book, Project 61-20, Sheet 56.
1968 Consumer Power Company's survey notes a found P.K. nail. N 45° W 67.00' Power Pole S 30° W 79.60' Telephone Pole S 45° E 60.0' Telephone Pole


POSITION OF SAID RECORDED CORNER REVIEWED & RATIFIED BY MUSKEGON COUNTY PEER GROUP IN ACCORDANCE WITH P.A. 345, OF 1990

B. Description of corner evidence found and/or method applied in restoring or reestablishing corner:

A P.K. nail was found in the centerline of Moorland Road and M-46. Witnesses verified with the 1968 Consumers Power Company's survey. Respective 1/2 mile measures from E-9 to E-8 and E-9 to F-9 are consistent with the 1968 and 1955 measures. Position of the existing corner was accepted due to the historical usage and documentation.

C. Description of monument for corner and accessories established to perpetuate locating the position of the corner:

- Replaced a P.K. nail with a 2 3/4" x 30" cast-iron monument that contains a "County Surveyors" cap, No. 28428.
S 28° W 77.30' Power Pole Found nail on N side
S 74° W 131.28' Power Pole Set 20D nail on S side
N 67° W 163.59' Power Pole Found P.K. nail on N side
N 36° W 41.67' Set 1/2" iron Rod next to Stop Sign
N 41° E 66.97' Power Pole Found nail on NWly side
S 32° E 59.30' Power Pole Found nail on SWly side

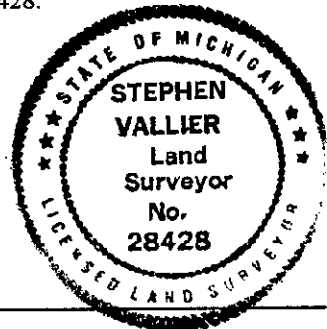

Signed by [Signature]
Surveyor's Michigan License No. 28428

Date 12/19/00
FORM APPROVED BY MICHIGAN STATE BOARD OF PROFESSIONAL SURVEYORS, JAN. 28, 197
REVISED MAY 14, 197
REVISED JAN., 198
REVISED OCT., 199

07154