

2000 DEC 27 AM 11: 07

For corners in

Muskegon Located In: _____ Corner Code # _____
(County)

1. Public Land Survey. T 10N R 14W _____ H-9
T _____ R _____
T _____ R _____
T _____ R _____

2. Property Controlling S _____ T _____ R _____ SURVEY &
in Section S _____ T _____ R _____ REMONUMENTATION

3. Miscellaneous S _____ T _____ R _____
Property in Sec. S _____ T _____ R _____ JAN 31 2001

Mark Fairchild
REGISTER OF DEEDS

Register of Deeds Stamp & File Number

4. Lot No. _____, Recorded Plat _____ SECTION _____

5. Private Claims _____

I, Stephen V. Vallier, in a field survey on October 9, 2000 do hereby state that under requirements of P.A. 74, Michigan P.A. of 1970, the corner points mentioned in lines 1 and 2 above were in conformance with regulations and rules therefore as required in the current manual of survey instructions of the United States Department of the Interior, Bureau of Land Management or by a decree of a Court of Law and /or that the corner points mentioned in lines 3, 4 and 5 above were in conformance with the rules of the Michigan Board of Land Surveyors or by a Decree of a Court of Law; established, re-established, monumented, recovered, found as expressed below:

	A	B	C	D	E	F	G	H	I	J	K	L	M
1													
2		6		5		4		3		2		1	
3													
4		7		8		9		10		11		12	
5													
6		18		17		16		15		14		13	
7													
8		19		20		21		22		23		24	
9													
10		30		29		28		27		26		25	
11													
12		31		32		33		34		35		36	
13													

NOTE: Not more than 2 corners, all in the same town and range, may be recorded on this certificate.

A. Description of original monument and accessories and/or subsequent restoration:

- 1837 John Mullett (G.L.O.) set post.
18" Hemlock for post
- 1950's Muskegon County Road Commission's witness sheet note P. K. nail.
N 53.90' Power Pole
NWW 42.64' 24" Oak
SSW 89.60' Power Pole
- 1960 Muskegon County Road Commission's witness book notes P. K. nail.
N 53.90' Power Pole
NWW 42.64' 24" Oak
SSW 89.60' Power Pole


POSITION OF SAID *Point*
RECORDED CORNER *10/3/00*
REVIEWED & RATIFIED
BY MUSKEGON COUNTY
PEER GROUP IN ACCORDANCE
WITH P.A. 345, OF 1990

B. Description of corner evidence found and/or method applied in restoring or reestablishing corner:

A 1/2" iron rod was found cemented in the bottom of a monument box. Verified with the 1960 Muskegon County Road Commission's witnesses. Corner is 1.75' East of a single proportionate measure for the mile. Position of the existing corner was accepted due to historical usage and documentation.

C. Description of monument for corner and accessories established to perpetuate locating the position of the corner:

- A 2 3/4" aluminium cap containing a "County Surveyors Cap", No. 28428, was set on top of the found a 1/2" iron rod inside a monument box. Monument box is in centerline of M-46.
- | | | | |
|---------|--------|---------------|------------------------|
| N 35° E | 78.18' | 24" Elm | Set 20D nail in E side |
| N 08° E | 53.89' | Power Pole | Found nail on E side |
| N 32° W | 42.64' | 48" White Oak | Found nail on W side |
| S 28° W | 39.47' | Power Pole | Found nail |
| S 42° W | 63.88' | 12" Pine | Found nail in N side |

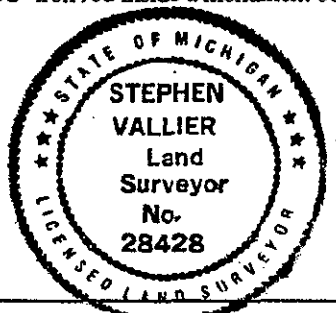

Signed by *Steph V Vallier*
Surveyor's Michigan License No. 28428

Date 12/19/00
FORM APPROVED BY MICHIGAN STATE BOARD OF PROFESSIONAL SURVEYORS, JAN. 28, 1971
REVISED MAY 14, 1975
REVISED JAN., 1983
REVISED OCT., 1995
A 2177