

For corners in

Muskegon Located In: _____ Corner Code # _____
(County)

1. Public Land Survey T 10N R R14W _____ I-9 _____
T _____ R _____
T _____ R _____
T _____ R _____

2. Property Controlling S _____ T _____ R _____ SURVEY &
in Section S _____ T _____ R _____ REMONUMENTATION

3. Miscellaneous S _____ T _____ R _____ JAN 31 2001
Property in Sec. S _____ T _____ R _____

2000 DEC 21 PM 12: 57

Mark Fairchild
REGISTER OF DEEDS

Register of Deeds Stamp & File Number


SECTION

4. Lot No. _____, Recorded Plat _____
5. Private Claims _____

I, Stephen V. Vallier, in a field survey on October 4, 2000 do hereby state that under requirements of P.A. 74, Michigan P.A. of 1970, the corner points mentioned in lines 1 and 2 above were in conformance with regulations and rules therefore as required in the current manual of survey instructions of the United States Department of the Interior, Bureau of Land Management or by a decree of a Court of Law and /or that the corner points mentioned in lines 3, 4 and 5 above were in conformance with the rules of the Michigan Board of Land Surveyors or by a Decree of a Court of Law; established, re-established, monumented, recovered, found as expressed below:

NOTE: Not more than 2 corners, all in the same town and range, may be recorded on this certificate.

A	B	C	D	E	F	G	H	I	J	K	L
1											
2	6	5	4	3	2	1					
3											
4	7	8	9	10	11	12					
5											
6	18	17	16	15	14	13					
7											
8	19	20	21	22	23	24					
9											
10	30	29	28	27	26	25					
11											
12	31	32	33	34	35	36					
13											

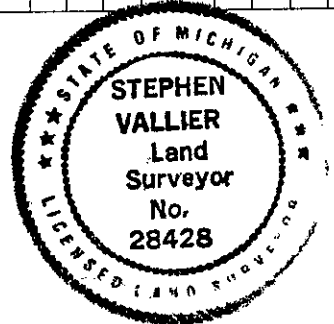

A. Description of original monument and accessories and/or subsequent restoration:

- 1837 John Mullett (G.L.O.) set post.
S 26° E 28" Sugar 7 Links
S 76° W 9" Beech 10 Links
- 1920 G. Liddle of the Muskegon County Road Commission found an iron pipe.
SE 79.7' Telephone Pole
NW 44.8' Transistor Pole
NW 62.4' Twin Elm
- 1950's The Muskegon County Road Commission's witness sheet notes a hub on the North edge of concrete.
SE 80.75' 6" Elm
SW 61.1' NW Corner Pump Post
NW 86.9' 12" Apple
- 1961 The Michigan Department of Transportation's (M.D.O.T.) Right of way book for Project Nos. 61-20, Sheet 56, shows no witnesses. Measure: H-9 to I-9 2681.36'
- 1974 John Lazarock found a 3/4" iron in a monument box, which is recorded in L.C.R.C., Liber 1047, Page 313.
SE 43.42' 6" Pole
NW 78.97' SW Curb
SE 84.15' SW Curb
- 1990 R. Jonker found a 3/4" iron rod in a monument box; survey recorded in L.C.R.C. Liber 1549, Page 578.
S 25° E 43.52' Power Pole Nail in SW side
N 35° E 62.67' Power Pole Nail in NW side
N 30° W 63.30' Power Pole Nail in SW side

B. Description of corner evidence found and/or method applied in restoring or reestablishing corner:

In October of 2000, a 3/4" iron rod was found in a monument box. Witnesses were verified with L.C.R.C. recorded in Liber 1549, Page 578 Also, the 1/2 mile measure was verified from H-9 to I-9 and checks with the M.D.O.T. distance of 1961. Position of the existing corner was accepted due to the historical usage and documentation.

C. Description of monument for corner and accessories established to perpetuate locating the position of the corner:

Replaced the 3/4" iron rod with a 2 3/4" x 30' cast-iron monument containing a "County Surveyors" cap, No. 28428, and placed in a monument box.

- S 28° E 43.62' Power Pole Found nail on SW side
- S 63° W 95.90' Power Pole Found nail on E side
- S 20° W 84.65' SE end of Curb Radius
- S 75° W 79.71' NW end of Curb Radius
- N 30° W 63.19' Power Pole Found nail on SW side
- N 34° E 62.70' Power pole Found nail on W side

POSITION OF SAID *Refer*
RECORDED CORNER *10/3/00*
REVIEWED & RATIFIED *5-*
BY MUSKEGON COUNTY
PEER GROUP IN ACCORDANCE
WITH P.A. 345, OF 1990

Signed by *Stephen V. Vallier* Date 12/19/00
Surveyor's Michigan License No. 28428

42159