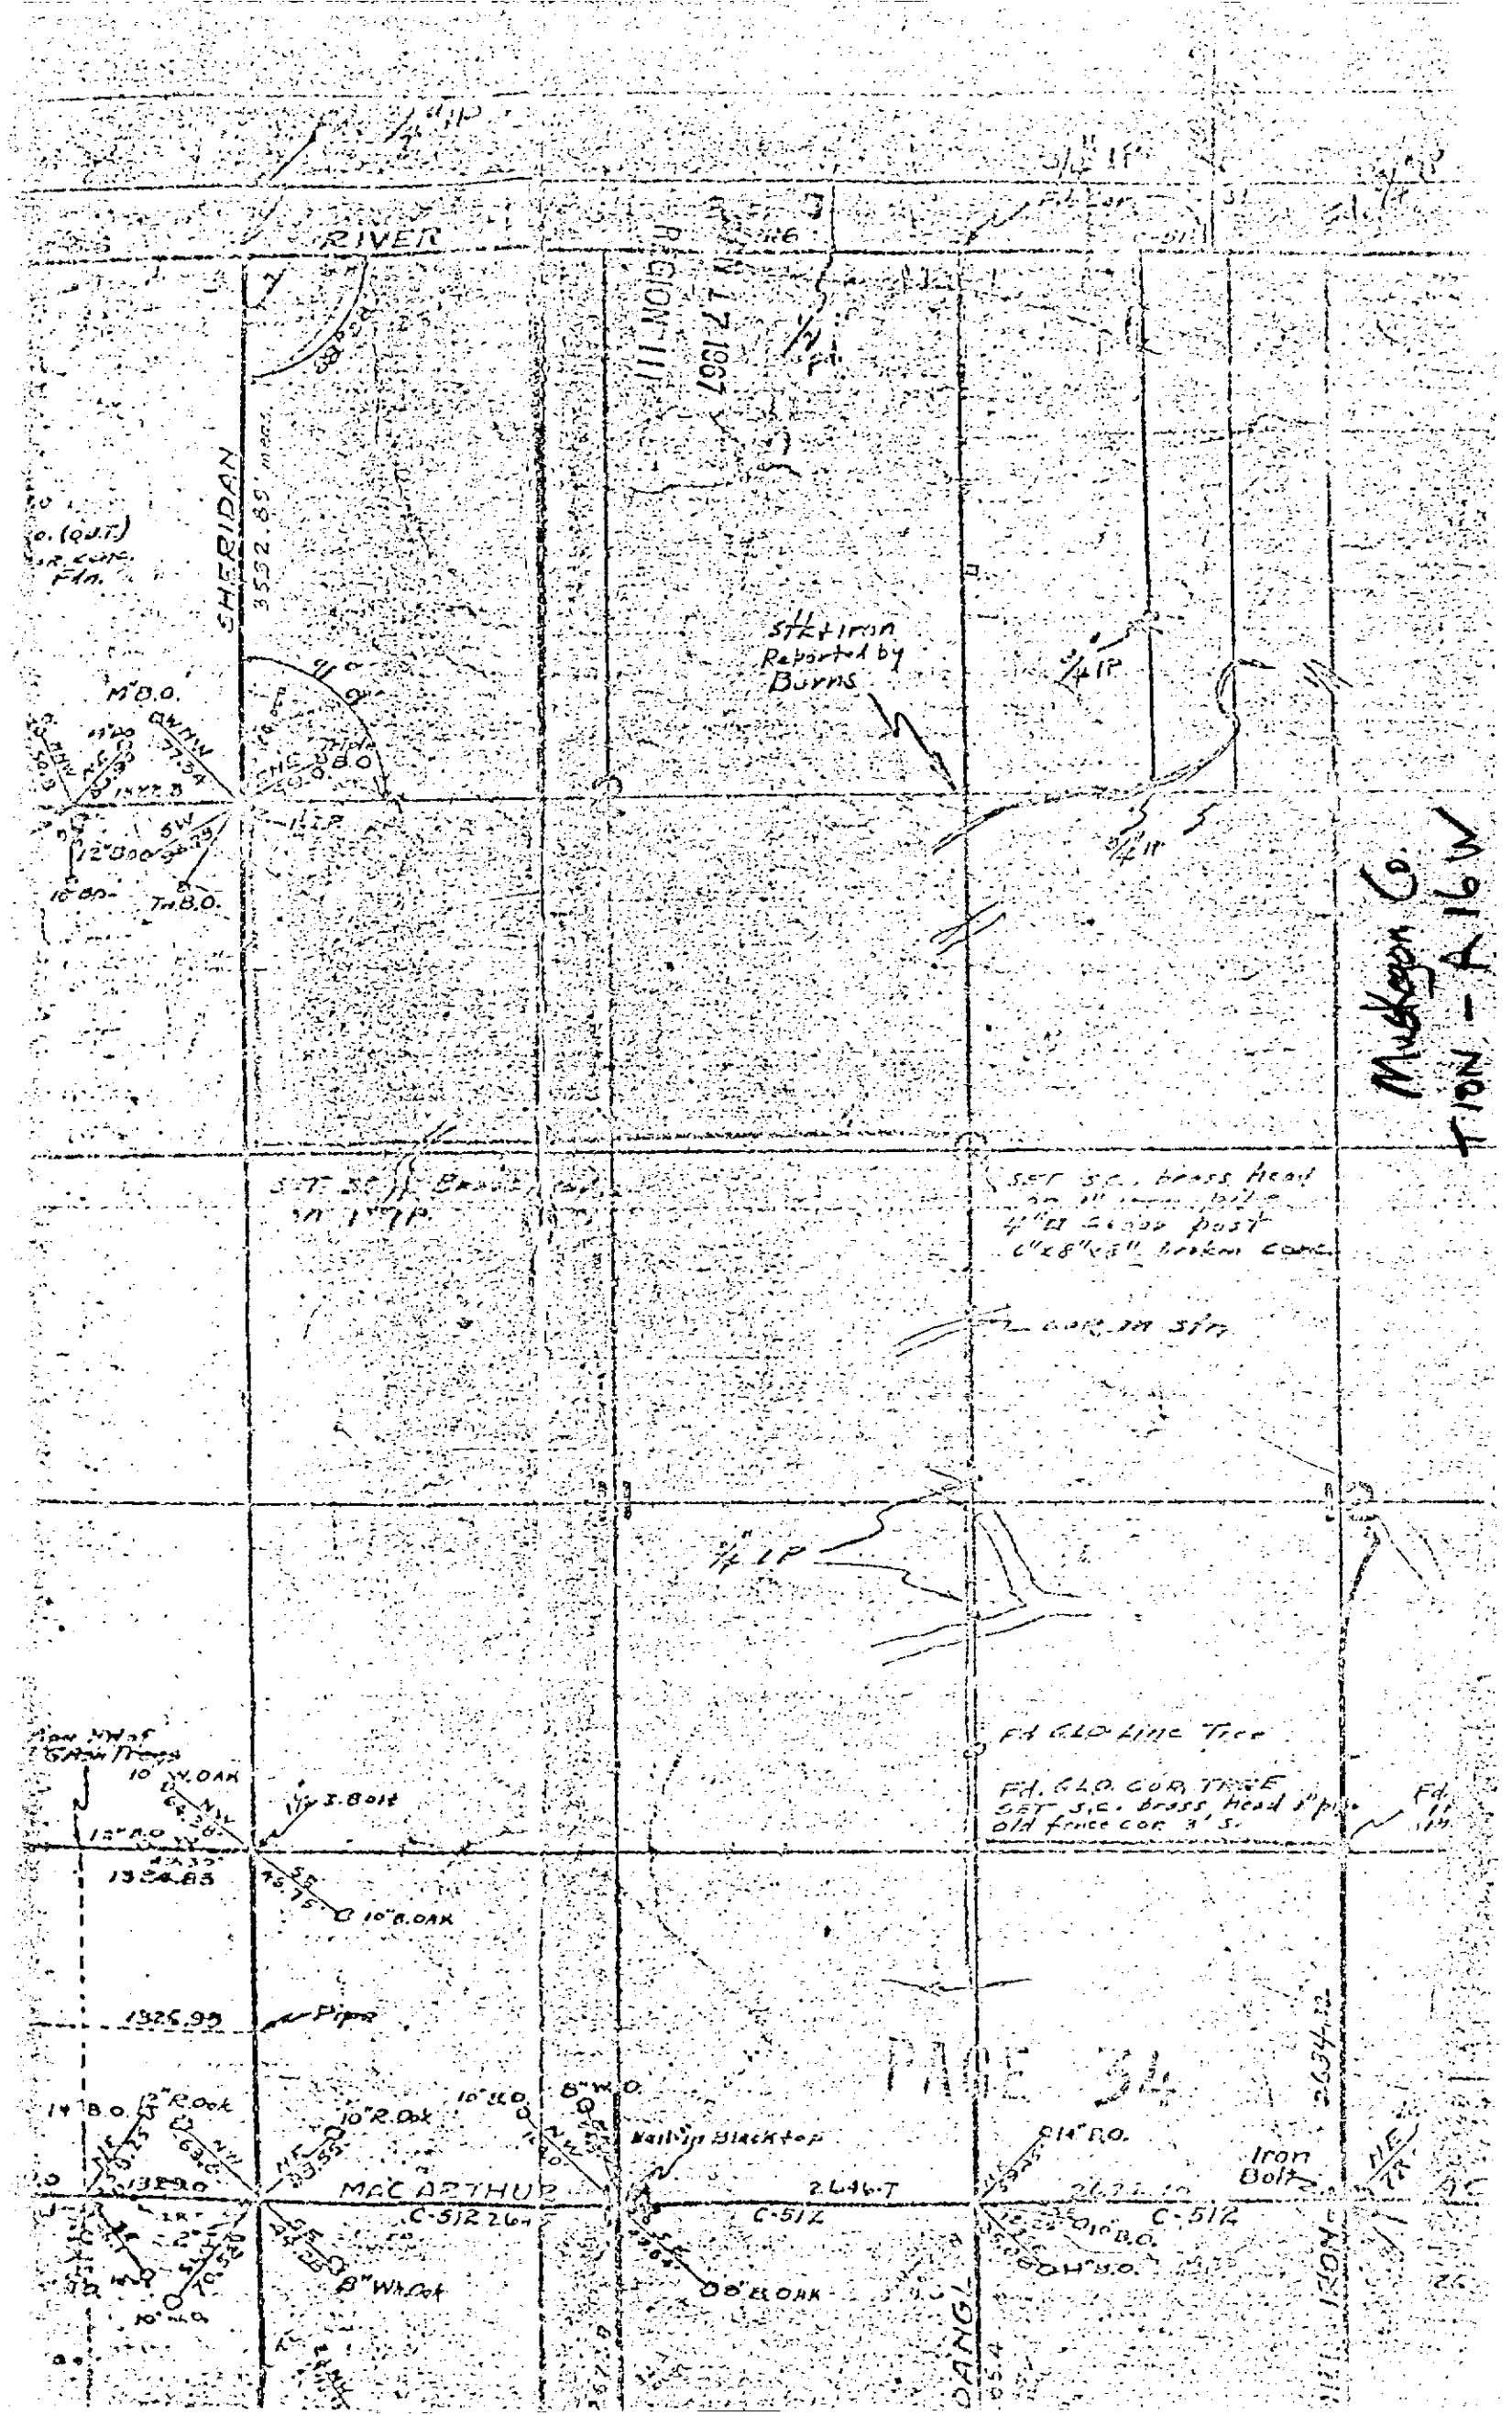
RIVER
SHERIDAN
3532.85' meas.
Stk+iron Reported by Burns
Muskegon Co.
TION - A 16W
SET S.C. brass head
4" □ Cedar post
6"x8"x8" broken conc.
Fd GLO Line Tree
Fd. GLO. COR. TREE
SET S.C. brass head 1" pipe
old fence cor 3' S.
10" W. OAK
10" B. OAK
1326.99
Pipe
PAGE 34
Nail in Blacktop
MAC ARTHUR
C-512
2646-T
Iron Bolt
8" W.O.
8" B. OAK
8" Wh. Oak
10" R. Oak
14" B.O.
10" B.O.
IRON
DANGL