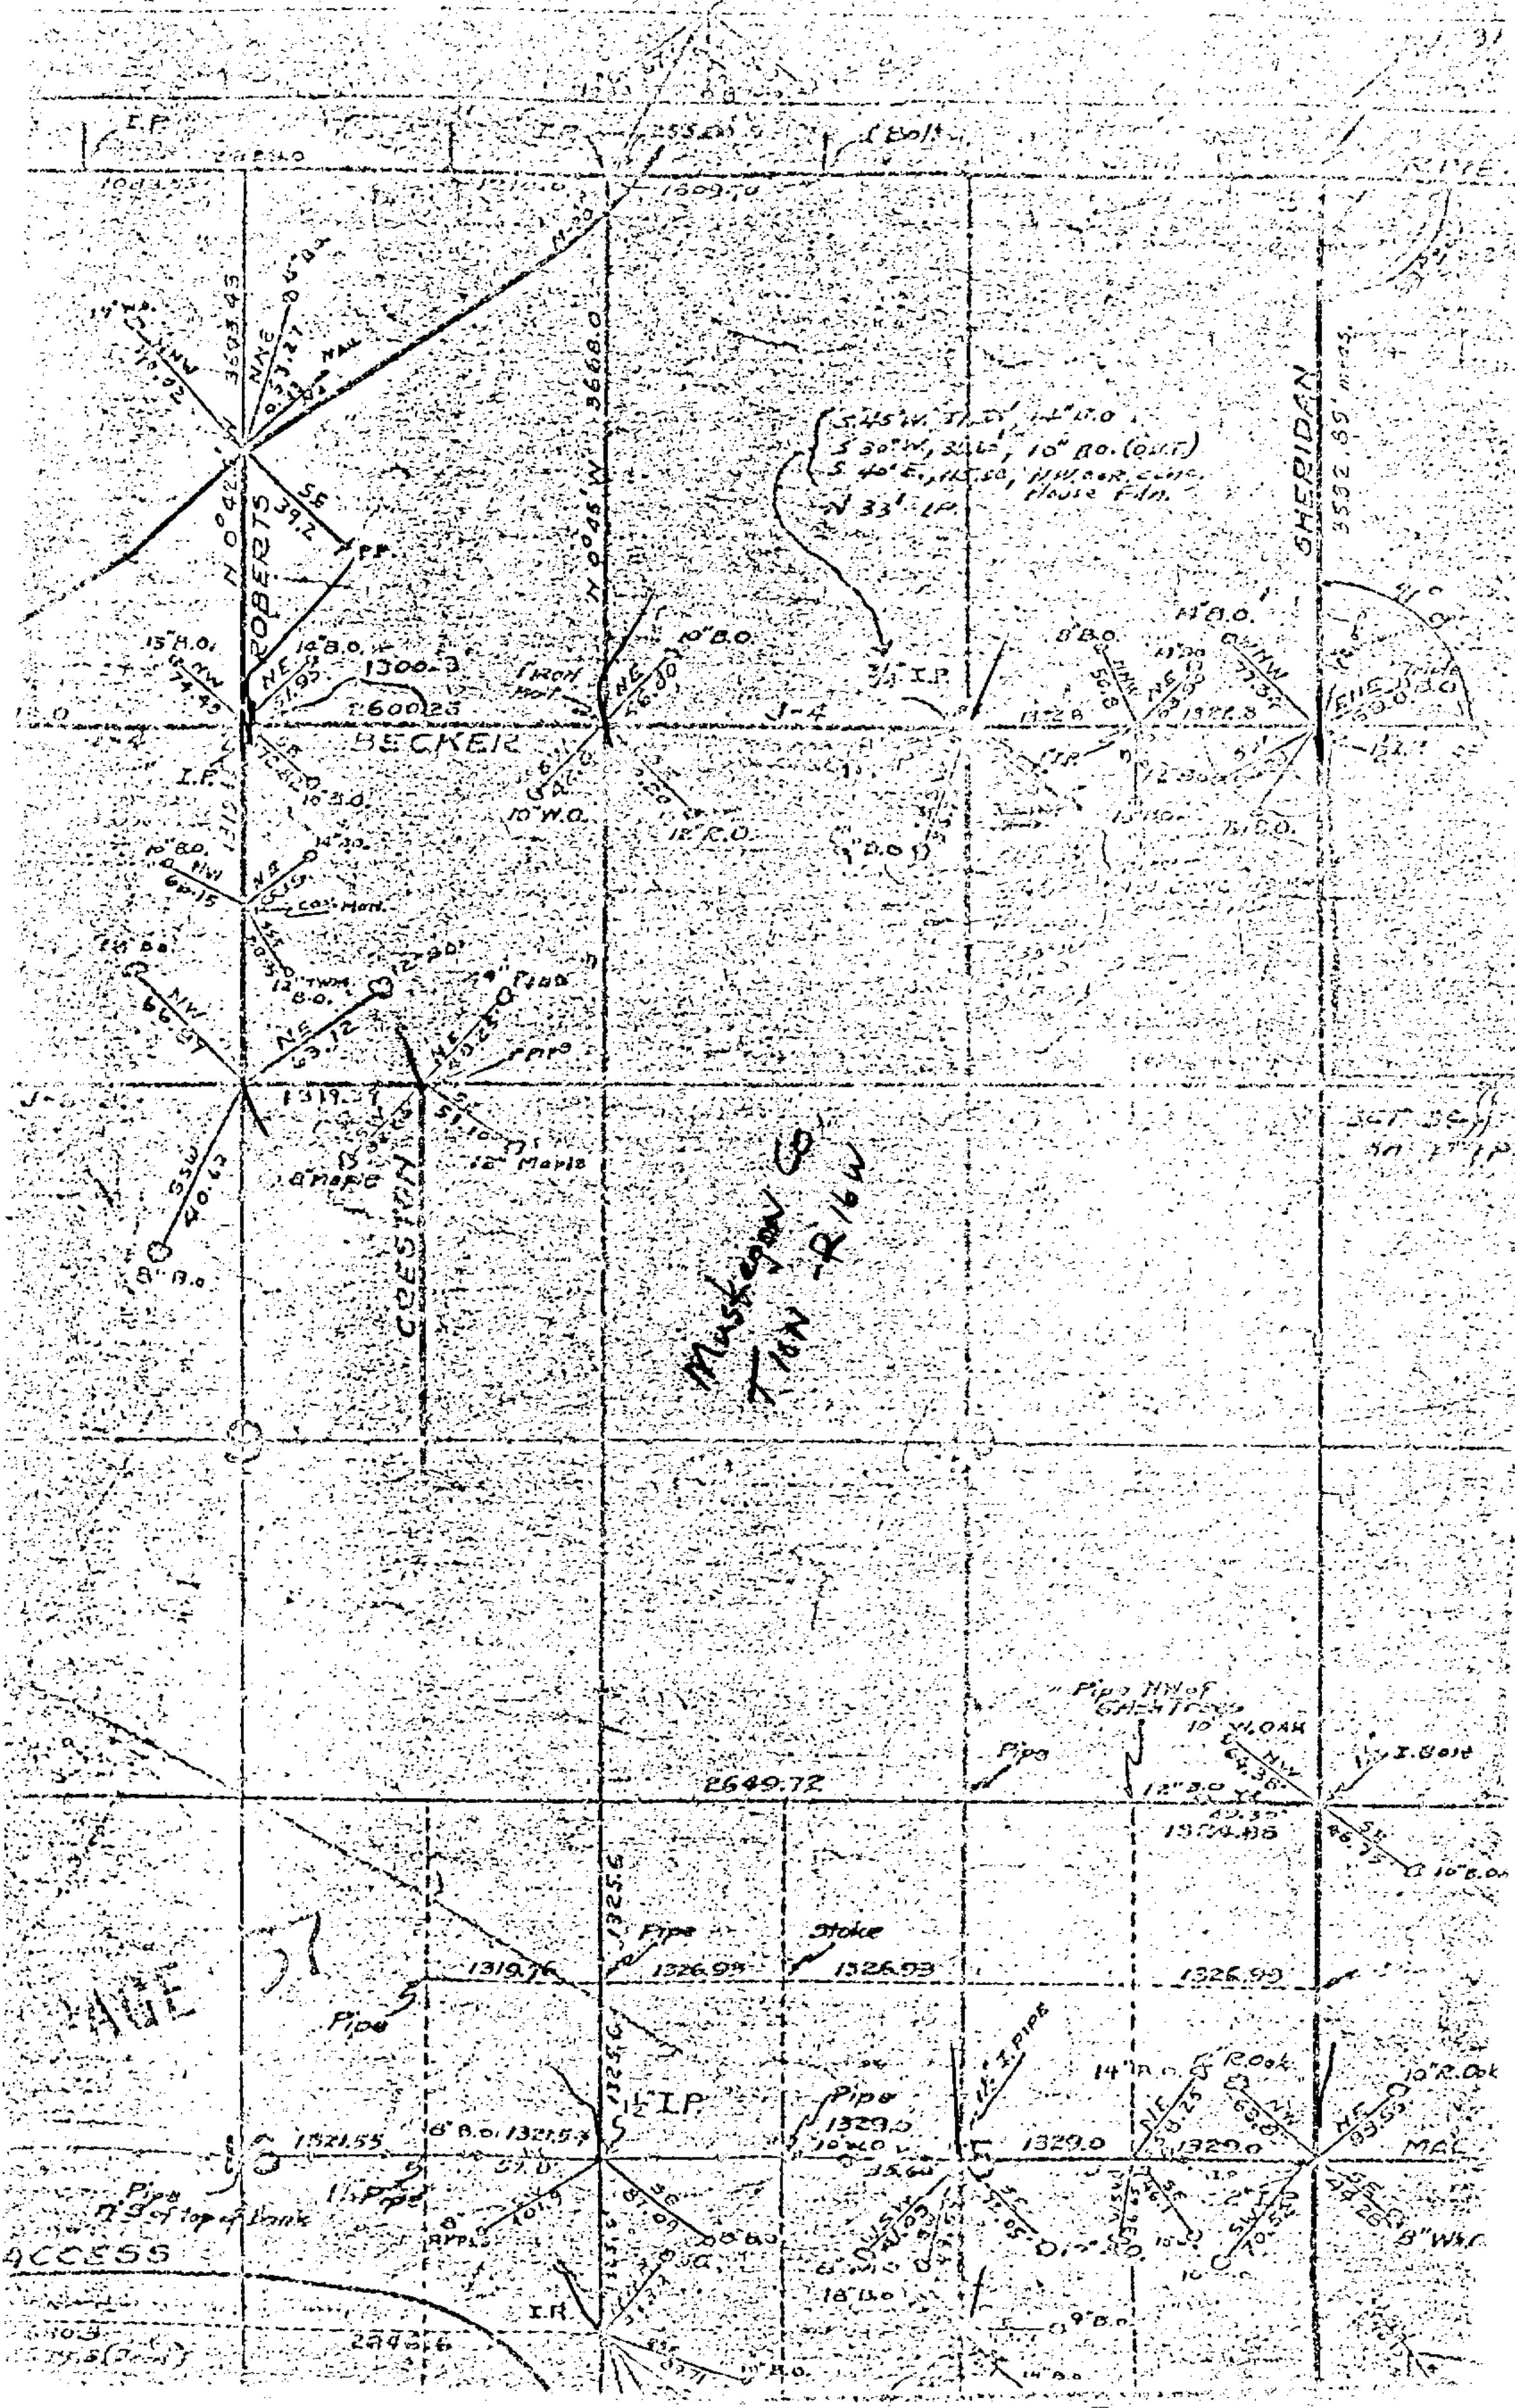
ROBERTS
BECKER
CRESTON
SHERIDAN
3503.45
N 0°45' W 3668.0
3532.89' meas.
S 45° W, 14" B.O.
S 30° W, 10" B.O. (Out)
S 40° E, NW cor. conc. House Fdn.
N 33' I.P.
¾" I.P.
J-4
1319.27
12" Maple
Muskegon Co
T 10N - R 16W
2649.72
1319.76
1326.93
1326.99
1329.0
1321.55
1½" I.P.
Pipe
Stake
Pipe NW of Gnd Trees
10" Y. Oak
10" R. Oak
8" Wh.O.
I.R.
ACCESS
MAC