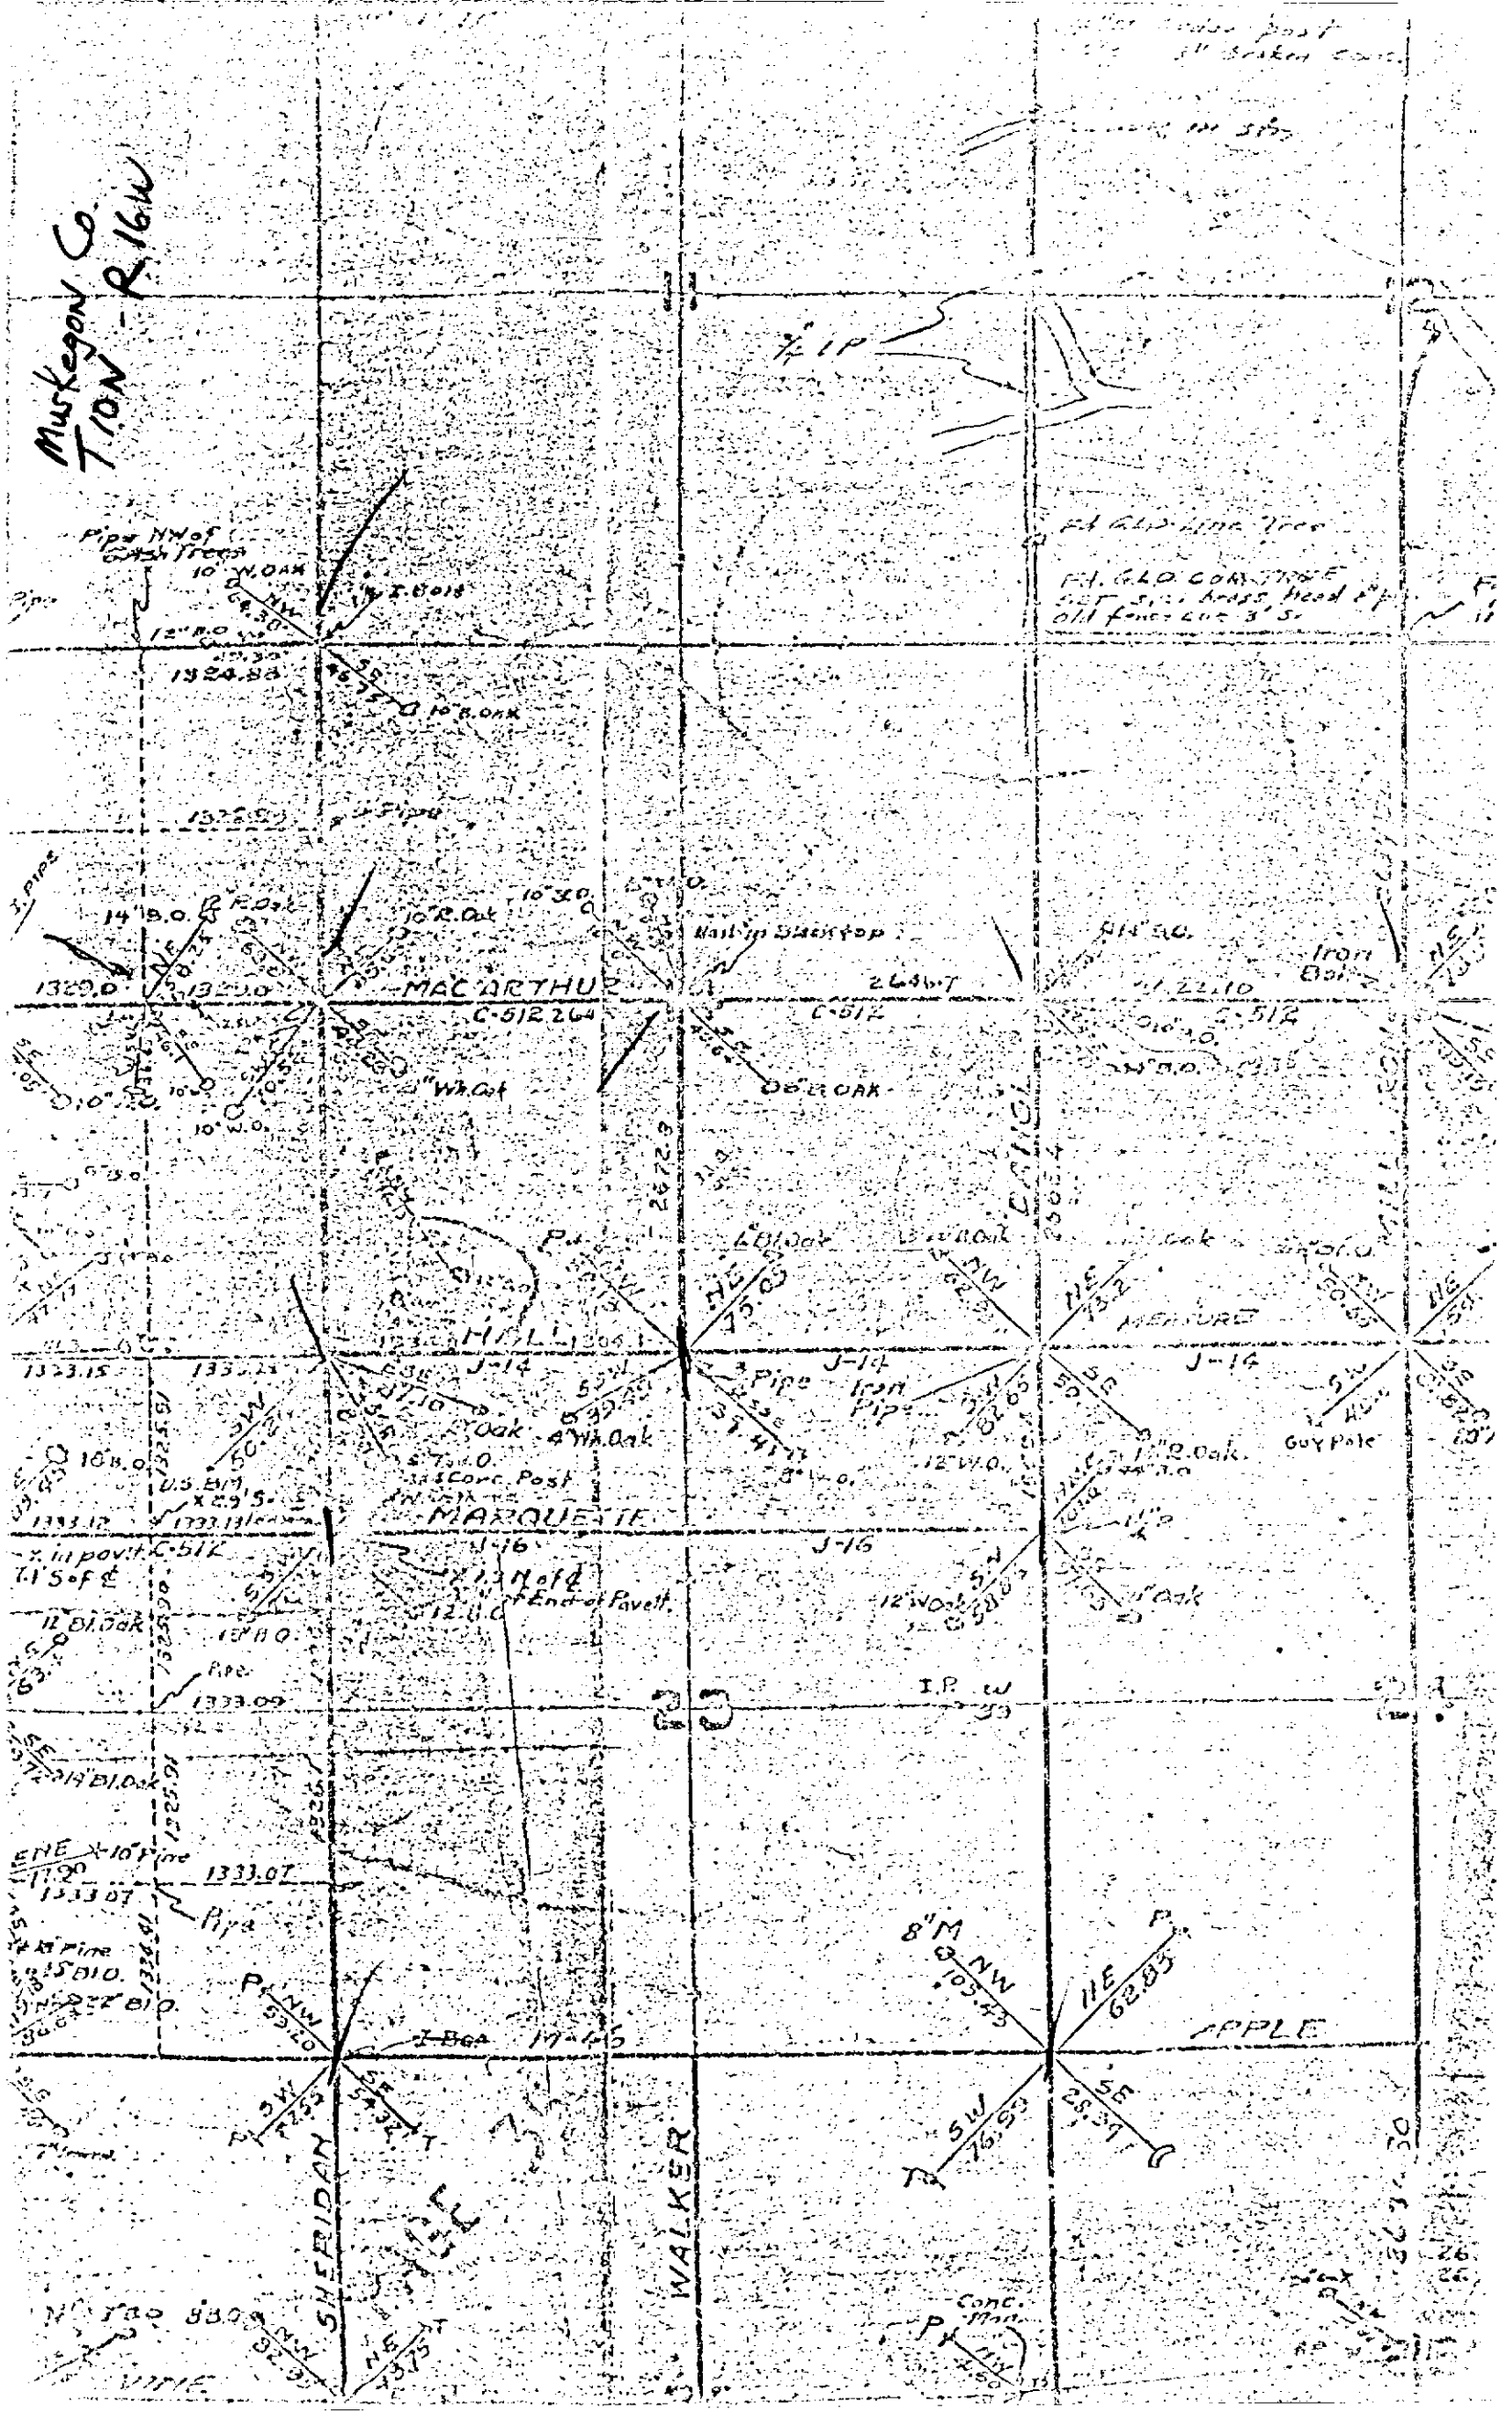
Muskegon Co.
T10N - R16W
MAC ARTHUR
C-512 264
C-512
HALL
J-14
MARQUETTE
J-16
SHERIDAN
WALKER
APPLE
Iron Bar
Guy Pole
Conc. Post
End of Pavett
Pipe
Conc. Man.