


Mackegon Co
10N 6W

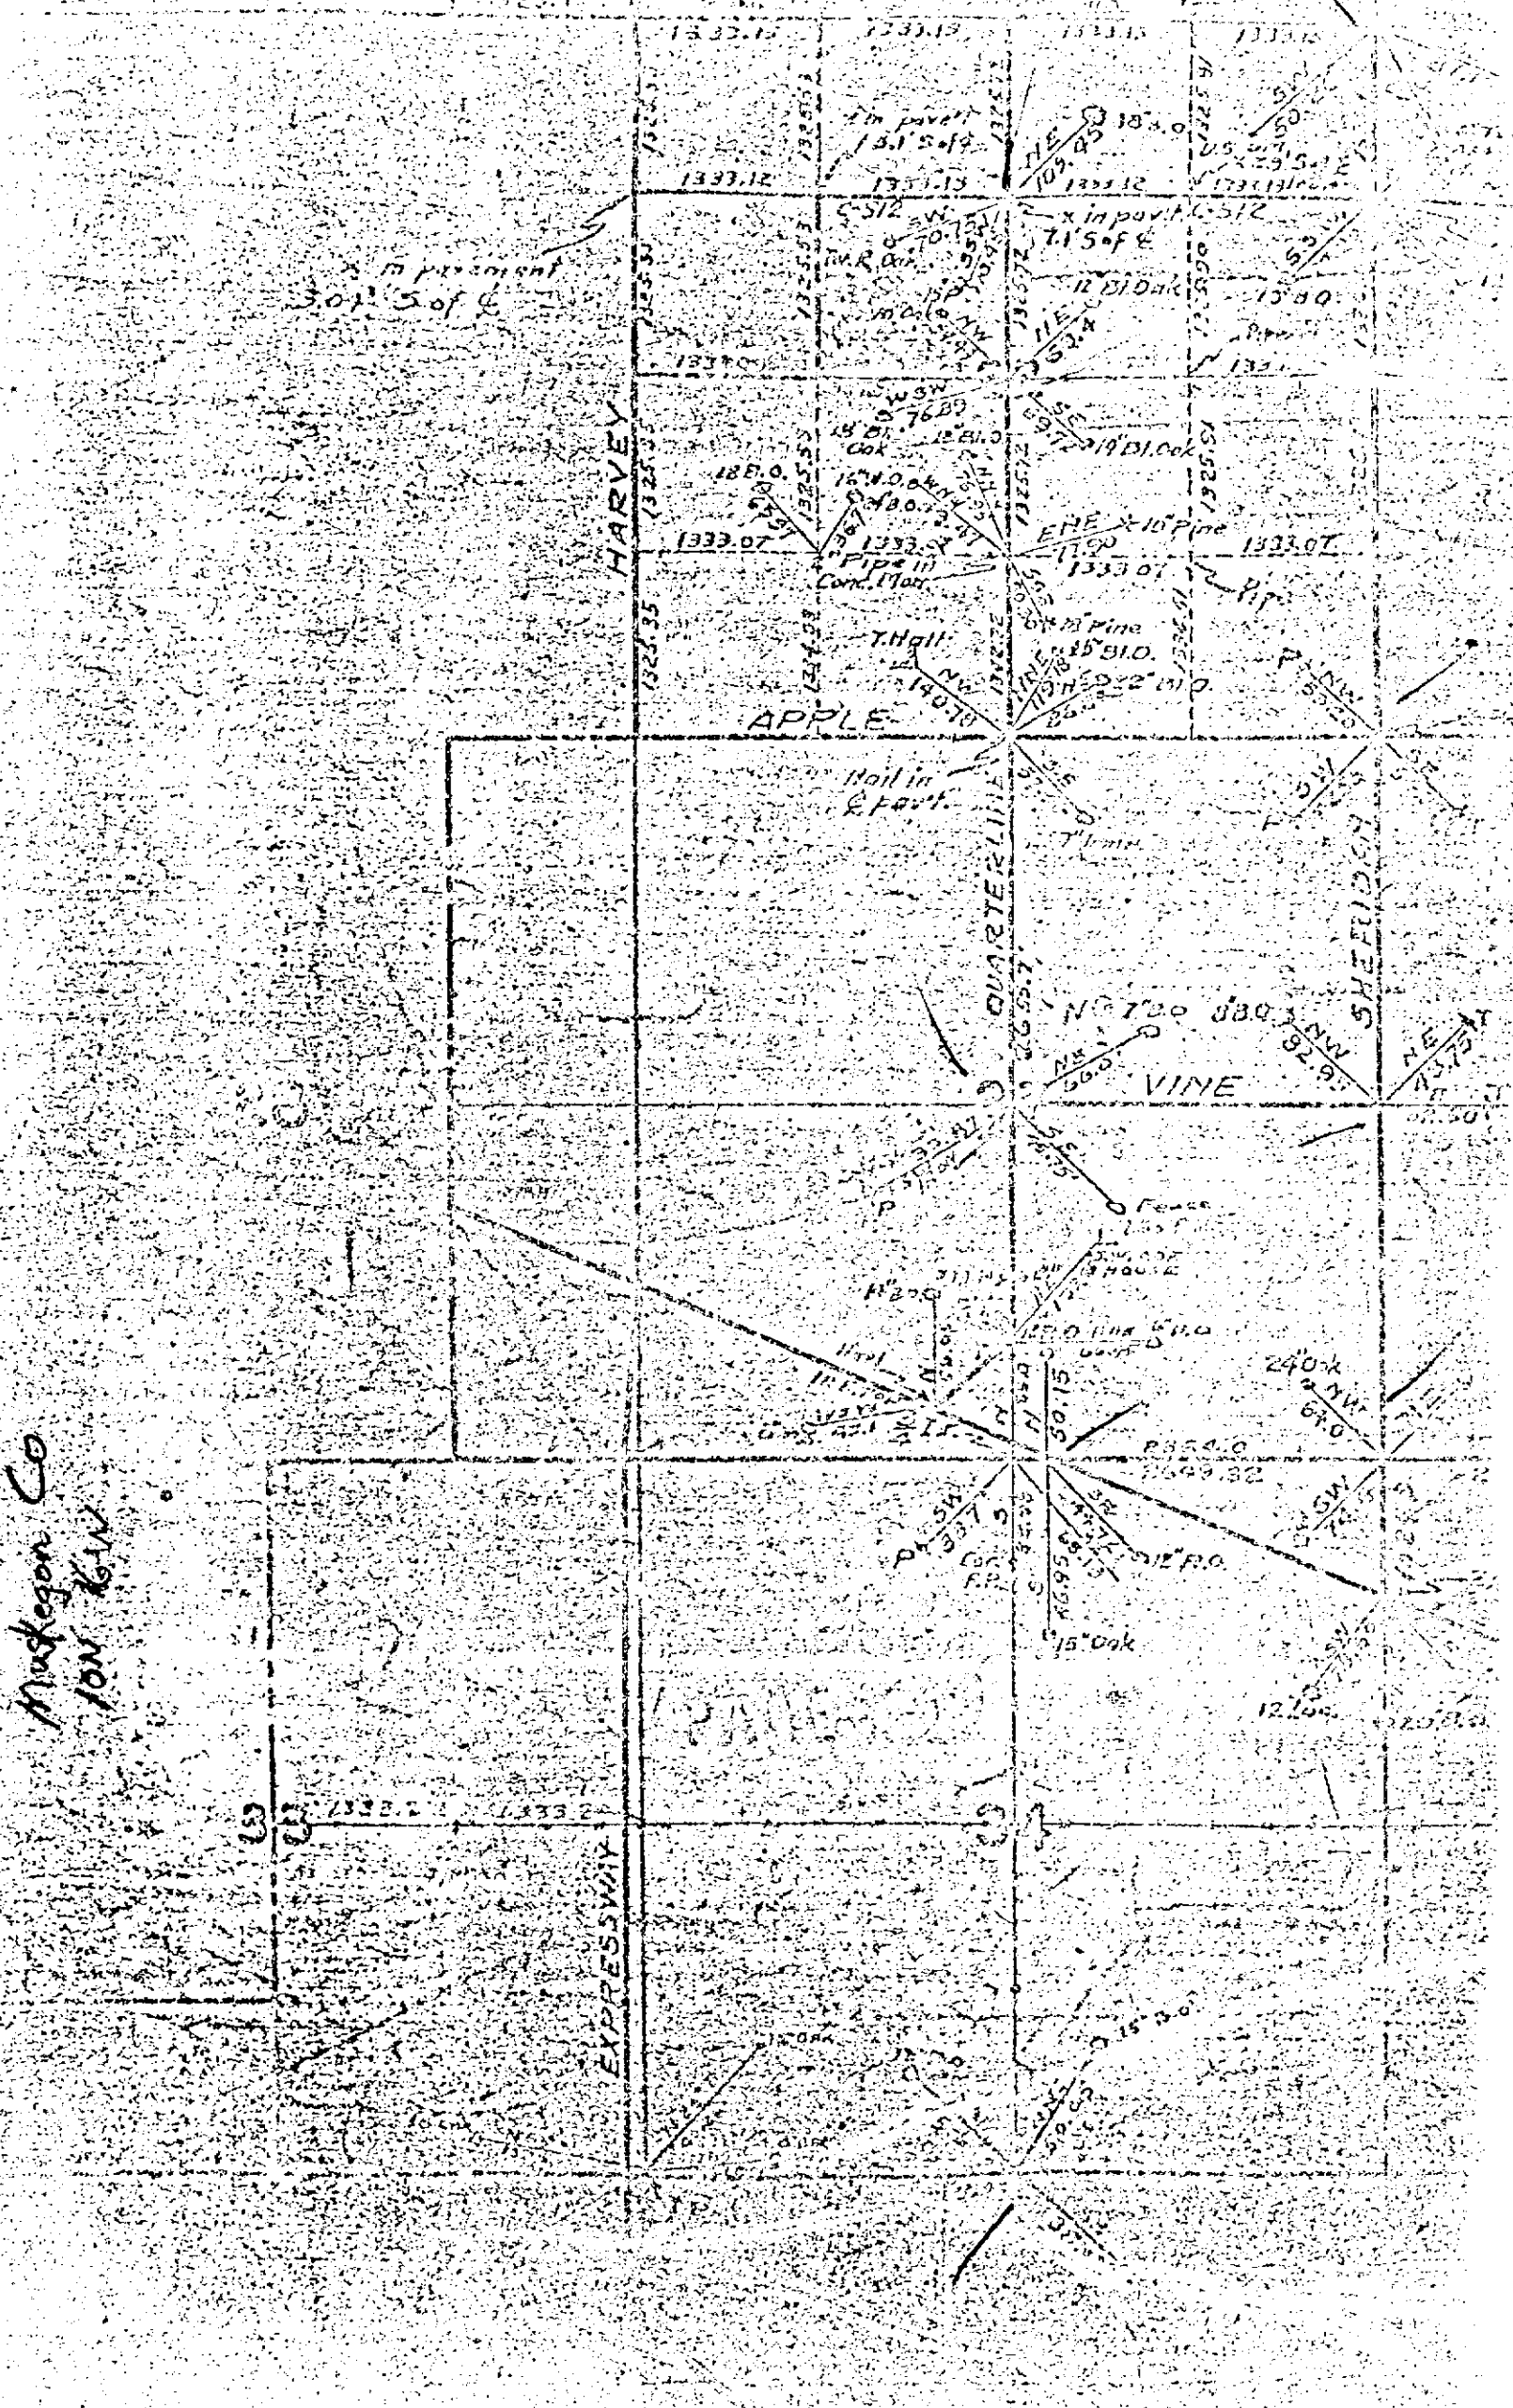

Improvement
301' 5 of E

HARVEY

APPLE

VINE


EXPRESSWAY

T. Hall

Hall in
E. part.

ERE 10 Pine

15 Pine

N 700 800

15 oak

15 oak

2 in pavent
13.1 soft

x in pavent
7.1 soft

18 7600
Oak

15 1333
PIPE IN
CORN. 1700

12 19 101 oak

15 910

15 500



240 x
670

12 100

15 200

15 200