

SAME AS A-4 ✓
TION, R16W

LAND CORNER RECORDATION CERTIFICATE
Filing Requirement of Act 74, Mich. P.A. 1970

1996 DEC 30 AM 8:48

For corners in
Muskegon
(County)

Located In:	Corner Code #
T 10N R 17W	M-4
T _____ R _____	_____
T _____ R _____	_____
T _____ R _____	_____
T _____ R _____	_____
S _____ T _____ R _____	_____
S _____ T _____ R _____	_____
S _____ T _____ R _____	_____
S _____ T _____ R _____	_____

Carr Carter
REGISTER OF DEEDS

A1844

Register of Deeds Stamp & File Number

- Public Land Survey
- Property Controlling in Section
- Miscellaneous Property in Sec.

NOV 28 2000

- Lot No. _____, Recorded Plat _____
- Private Claims _____

SECTION

A	B	C	D	E	F	G	H	I	J	K	L
2	6	5	4	3	2	1					
3											
4	7	8	9	10	11	12					
5											
6	18	17	16	15	14	13					
7											
8	19	20	21	22	23	24					
9											
10	30	29	28	27	26	25					
11											
12	31	32	33	34	35	36					
13											

I, Stanley H. Shackelford, P.S. in a field survey on October 30, 1996, do hereby certify that under requirements of P.A. 74, Michigan P.A. of 1970, the corner points mentioned in lines 1 and 2 above were in conformance with regulations and rules therefore as required in the current manual of survey instructions of the United States Department of the Interior, Bureau of Land Management or by a decree of a Court of Law and/or that the corner points mentioned in lines 3, 4 and 5 above were in conformance with the rules of the Michigan Board of Land Surveyors or by a Decree of a Court of Law; established, re-established, monumented, re-monumented, recovered, found as expressed below:

NOTE: Not more than 4 corners, all in the same town and range, may be recorded on this certificate.

- A. Description of original monument and accessories and/or subsequent restoration:
- | | | | |
|------------------------|----------------|----------|-------------|
| 1837 G.L.O. SET CORNER | SOUTH 29° WEST | 27 LINKS | 20" HEMLOCK |
| | NORTH 33° WEST | 34 LINKS | 20" HEMLOCK |

1950's M.C.R.C. CORNER NOT MENTIONED

SOUTHWEST	46.50'	CENTER OF IRON STREET SIGN
	2711.54'	TO CENTER SECTION
EAST	17.55'	WEST END OF HEAD WALL

SEE ATTACHED "EXHIBIT M-4"

- B. Description of corner evidence found and/or method applied in restoring or reestablishing corner:

FOUND 2 3/4" X 30" CAST IRON MONUMENT WITH COUNTY SURVEYOR LEGEND IN MONUMENT BOX.

NORTH 10° WEST	92.06'	TELEPHONE POLE
SOUTH 42° EAST	37.29'	POWER POLE
SOUTH 21° WEST	63.54'	TELEPHONE POLE
SOUTH 51° WEST	102.82'	NE CORNER HOUSE


CHECKS WITH POSITION OF HISTORICAL USAGE.
CHECKS WITH 1950's MEASURE TO WEST.

POSITION OF SAID
RECORDED CORNER *sw*
REVIEWED & RATIFIED *4/10/96*
BY MUSKEGON COUNTY
PEER GROUP IN ACCORDANCE
WITH P.A. 345, OF 1990

- C. Description of monument for corner and accessories established to perpetuate ~~locating the position of the corner~~

FOUND 2 3/4" X 30" CAST IRON MONUMENT WITH COUNTY SURVEYOR LEGEND IN MONUMENT BOX.

NORTH 10° WEST	92.06'	TELEPHONE POLE	FOUND SPIKE
SOUTH 42° EAST	37.29'	POWER POLE	FOUND SPIKE
NORTH 21° WEST	63.54'	TELEPHONE POLE	FOUND SPIKE
SOUTH 51° WEST	102.82'	NE CORNER HOUSE	

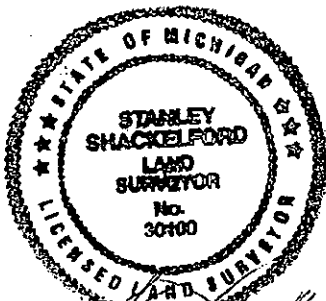

Signed by *Stanley H. Shackelford*
Surveyor's Michigan License No. 30100

Date 12-26-96

A1844

9.00

LIBEP 1952 PAGE 816