

MAR 06 1998

STATE OF MICHIGAN
COUNTY OF MUSKEGON
RECEIVED
1997 DEC 30 PM 3:22

SECTION

LAND CORNER RECORDATION CERTIFICATE

Filing Requirement of Act 74, Mich. P.A. 1970

For corners in

Muskegon (County) Located In: Corner Code ##

1. Public Land Survey T 10N R17W... B-2
 T R
 T R
 T R

2. Property Controlling in Section S T R
 S T R

3. Miscellaneous Property in Sec. S T R
 S T R

Carrie Carter
REGISTER OF DEEDS

Register of Deeds Stamp & File Number

- 4. Lot No. _____, Recorded Plat _____
- 5. Private Claims _____

A	B	C	D	E	F	G	H	I	J	K	L	M
2	5	4	3	2	1							
3												
4	7	8	9	10	11	12						
5												
6	18	17	16	15	14	13						
7												
8	19	20	21	22	23	24						
9												
10	30	29	28	27	26	25						
11												
12	31	32	33	34	35	36						
13												

I, Stephen V. Vallier P.S., in a field survey on November 14, 1997, do hereby certify that under requirements of P.A. 74, Michigan P.A. of 1970, the corner points mentioned in lines 1 and 2 above were in conformance with regulations and rules therefore as required in the current manual of survey instructions of the United States Department of the Interior, Bureau of Land Management or by a decree of a Court of Law and/or that the corner points mentioned in lines 3, 4 and 5 above were in conformance with the rules of the Michigan Board of Land Surveyors or by a Decree of a Court of Law; established, re-established, monumented, re-monumented, recovered, found as expressed below:

NOTE: Not more than 4 corners, all in the same town and range, may be recorded on this certificate.

A. Description of original monument and accessories and/or subsequent restoration:

Corner Not Set By G.L.O.
 1926 Miscellaneous Survey Records - Transnation Title - M. Buck
 1950 M.C.R.C. Tie Map
 North/Northwest 45.71 Feet 14 Inch Oak
 Northwest 52.48 Feet 10 Inch White Pine
 South/Southeast 30.39 Feet 26 Inch Oak
 South 18.80 Feet 24 Inch Black Oak
 1990 L.C.R.C. Liber 1516, Page 397 - R.J. Hepworth
 Origin Uncertain But Survey Shows Center Section Found 1 Inch Iron

B. Description of corner evidence found and/or method applied in restoring or reestablishing corner:

Found 1 Inch By 18 Inch Iron Pipe. Distances related to 1926 M Buck Survey is as Follows.

	1997	1926
Center Section to North Quarter Corner	4206.22 Feet	4205.00 Feet
Center Section to East Quarter Corner	2649.50 Feet	2649.60 Feet


Origin and Survey Uncertain but Usage and Documentation Verify Position of Corner

POSITION OF SAID RECORDED CORNER REVIEWED & RATIFIED BY MUSKEGON COUNTY FIELD GROUP IN ACCORDANCE WITH P.A. 345, OF 1990

C. Description of monument for corner and accessories established to perpetuate locating the position of the corner:

Replaced 1 Inch By 18 Inch Iron Pipe with 2 3/4 Inch By 30 Inch Cast Iron Monument With County Surveyors Cap.
 North 30° East 34.50 Feet 8 Inch Red Pine Found Nail Southeast Side
 North 20° West 46.62 Feet 12 Inch White Pine Found Nail Southeast Side
 North 74° West 5.77 Feet 4 Inch Oak Found Nail South Side
 South 27° East 4.70 Feet 6 Inch Maple Found Nail East Side
 North 50° East 40.08 Feet 6 Inch P. Pine Found Nail Southeast Side
 South 66° East 17.70 Feet 12 Inch Oak Stump Found Spike Southwest Side

Signed by _____
 Surveyor's Michigan License No. _____

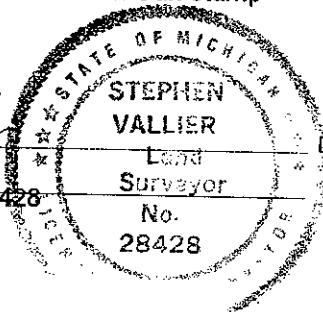

Date December 15, 1997

A1916