

MAR 06 1998

LAND CORNER RECORDATION CERTIFICATE
Filing Requirement of Act 74, Mich. P.A. 1970

STATE OF MICHIGAN
 COUNTY OF MUSKEGON
 RECEIVED FOR RECORD
 1997 DEC 30 PM 3:24

For corners in **SECTION**
 Muskegon

| (County) | Located In: | Corner Code # |
|------------------------------------|---|---------------|
| 1. Public Land Survey | T <u>10NR</u> <u>17W</u> | <u>C-2</u> |
| | T <u> </u> R <u> </u> | <u> </u> |
| | T <u> </u> R <u> </u> | <u> </u> |
| | T <u> </u> R <u> </u> | <u> </u> |
| 2. Property Controlling in Section | S <u> </u> T <u> </u> R <u> </u> | <u> </u> |
| | S <u> </u> T <u> </u> R <u> </u> | <u> </u> |
| 3. Miscellaneous Property in Sec. | S <u> </u> T <u> </u> R <u> </u> | <u> </u> |
| | S <u> </u> T <u> </u> R <u> </u> | <u> </u> |

Carrie Carter
 REGISTER OF DEEDS

Register of Deeds Stamp & File Number

4. Lot No. _____, Recorded Plat _____
 5. Private Claims _____

| A | B | C | D | E | F | G | H | I | J | K | L | M |
|----|----|----|----|----|----|----|---|---|---|---|---|---|
| 2 | 6 | ● | 5 | 4 | 3 | 2 | 1 | | | | | |
| 3 | | | | | | | | | | | | |
| 4 | 7 | 8 | 9 | 10 | 11 | 12 | | | | | | |
| 5 | | | | | | | | | | | | |
| 6 | 18 | 17 | 16 | 15 | 14 | 13 | | | | | | |
| 7 | | | | | | | | | | | | |
| 8 | 19 | 20 | 21 | 22 | 23 | 24 | | | | | | |
| 9 | | | | | | | | | | | | |
| 10 | 30 | 29 | 28 | 27 | 26 | 25 | | | | | | |
| 11 | | | | | | | | | | | | |
| 12 | 31 | 32 | 33 | 34 | 35 | 36 | | | | | | |
| 13 | | | | | | | | | | | | |

Stanley H. Shackelford, P.S.

97

I, _____, in a field survey on AUGUST 22, 19____, do hereby certify that under requirements of P.A. 74, Michigan P.A. of 1970, the corner points mentioned in lines 1 and 2 above were in conformance with regulations and rules therefore as required in the current manual of survey instructions of the United States Department of the Interior, Bureau of Land Management or by a decree of a Court of Law and/or that the corner points mentioned in lines 3, 4 and 5 above were in conformance with the rules of the Michigan Board of Land Surveyors or by a Decree of a Court of Law; established, re-established, monumented, re-monumented, recovered, found as expressed below:

NOTE: Not more than 4 corners, all in the same town and range, may be recorded on this certificate.

A. Description of original monument and accessories and/or subsequent restoration:

C-2 G.L.O. Set Post June 1, 1837

North 26° West 31.68 Feet 30-Inch Pine
 North 64° East 6.60 Feet 24-Inch Pine

County Survey Records 1940's Physical Corner Not Identified
 Southeast 49.94 Feet 12-Inch Maple Found Nail
 Southeast 50.50 Feet 16-Inch Pine Found Nail
 Southwest 37.30 Feet Twin Oak Found Nail

(See Attached)

B. Description of corner evidence found and/or method applied in restoring or reestablishing corner:

C-2 Found Cast Iron Monument with County Surveyor's Legend

South 25° East 57.13 Feet 14-Inch Pine Found Spike West Side
 North 40° West 37.20 Feet 26-Inch Oak Set Spike Easterly Side
 North 45° East 50.05 Feet 12-Inch Oak Found Nail Northwesterly Side
 South 40° West 56.00 Feet 16-Inch Oak Found Spike East Side
 South 62° West 41.43 Feet Power Pole Set Spike Northeast Side


POSITION OF SAID
 RECORDED CORNER
 REVIEWED & RATIFIED
 BY MUSKEGON COUNTY
 PEER GROUP IN ACCORDANCE
 WITH P.A. 345, OF 1990

sw
11/4/97

C. Description of monument for corner and accessories established to perpetuate locating the position of the corner:

C-2 Found Cast Iron Monument with County Surveyor's Legend

South 25° East 57.13 Feet 14-Inch Pine Found Spike West Side
 North 40° West 37.20 Feet 26-Inch Oak Set Spike Northwest Side
 North 45° East 50.06 Feet 12-Inch Oak Found Spike Northwest Side
 South 40° West 56.00 Feet 16-Inch Oak Found Spike East Side
 South 62° West 41.43 Feet Power Pole Set Spike Southeast Side

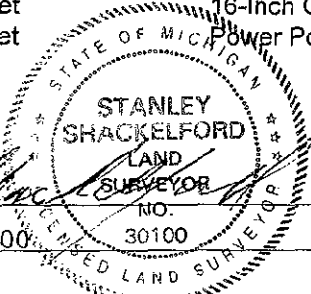

Signed by *Stanley H. Shackelford*
 Surveyor's Michigan License No. 30100

Date DECEMBER 15, 1997

A1936

T10N R17W E-2

| | | | |
|-----------|------------|-------------|-------------|
| Southwest | 56.00 Feet | 14-Inch Oak | Found Spike |
| Northeast | 50.10 Feet | 12-Inch Oak | Found Spike |
| Northwest | 37.10 Feet | 14-Inch Oak | Found Spike |

Liber 1296, Page 724 Recorded by D. Schiele in 1984

Found 1-Inch Pinched Iron

| | | |
|-----------|------------|-------------|
| Northeast | 50.10 Feet | 13-Inch Oak |
| Southwest | 56.00 Feet | 16-Inch Oak |
| Northwest | 37.30 Feet | 24-Inch Oak |

Liber 1301, Page 578 Recorded by C. Lewandoski in 1984

Found 1-Inch Iron

Set 4 x 32-Inch Cast Iron Monument with County Surveyor's Legend

| | | |
|----------------|------------|--------------|
| South 25° East | 57.13 Feet | 16-inch Pine |
| North 40° West | 37.20 Feet | 22-Inch Oak |
| North 45° East | 50.05 Feet | 12-Inch Oak |
| South 40° West | 56.00 Feet | 16-Inch Oak |

Liber 1605, Page 402 Recorded by D. Schiele

Found Cast Iron Monument

Position checks with Witnesses of Liber 1301, Page 578

SURVEY &
REMONUMENTATION

MAR 06 1998

SECTION