

SURVEY & REMONUMENTATION

MAR 06 1998

LIBER 2052 PAGE 601
LAND CORNER RECORDATION CERTIFICATE
 Filing Requirement of Act 74, Mich. P.A. 1970

STATE OF MICHIGAN
 COUNTY OF MUSKEGON
 RECEIVED FOR RECORDING

1997 DEC 30 PM 3:22

For corners in **SECTION**

MUSKEGON
 (County)

Located In:

Corner Code #

- | | | |
|------------------------------------|---------------------------|-------|
| 1. Public Land Survey | T <u>10N</u> R <u>17W</u> | D-1 |
| | T _____ R _____ | _____ |
| | T _____ R _____ | _____ |
| | T _____ R _____ | _____ |
| 2. Property Controlling in Section | S _____ T _____ R _____ | _____ |
| | S _____ T _____ R _____ | _____ |
| 3. Miscellaneous Property in Sec. | S _____ T _____ R _____ | _____ |
| | S _____ T _____ R _____ | _____ |

Carrus Carter
 REGISTER OF DEEDS

Register of Deeds Stamp & File Number

4. Lot No. _____, Recorded Plat _____
 5. Private Claims _____

I, Stephen V. Vallier P.S., in a field survey on November 14, 19 97, do hereby certify that under requirements of P.A. 74, Michigan P.A. of 1970, the corner points mentioned in lines 1 and 2 above were in conformance with regulations and rules therefore as required in the current manual of survey instructions of the United States Department of the Interior, Bureau of Land Management or by a decree of a Court of Law and/or that the corner points mentioned in lines 3, 4 and 5 above were in conformance with the rules of the Michigan Board of Land Surveyors or by a Decree of a Court of Law; established, re-established, monumented, re-monumented, recovered, found as expressed below:

A	B	C	D	E	F	G	H	I	J	K	L	M
2	6	5	4	3	2	1						
3												
4	7	8	9	10	11	12						
5												
6	18	17	16	15	14	13						
7												
8	19	20	21	22	23	24						
9												
10	30	29	28	27	26	25						
11												
12	31	32	33	34	35	36						
13												

NOTE: Not more than 4 corners, all in the same town and range, may be recorded on this certificate.

A. Description of original monument and accessories and/or subsequent restoration:

Corner Not Set By G.L.O.
 1977 Found In Monument Box - F.F. Smith
 L.C.R.C. - Liber 1129, Page 945

Northwest	71.30 Feet	10 Inch Maple	Found Spike
Southeast	61.87 Feet	Telephone Pole	Found Spike
Northeast	61.80 Feet	12 Inch Oak	Found Spike

B. Description of corner evidence found and/or method applied in restoring or reestablishing corner:

Found 1/2 inch Iron Rod 16 Inches in Length Fitting Over 3/4 Inch by 3 Foot Iron Pipe Above 1/2 Inch Boat Spike Driven in 1 Inch by 32 Inch Iron Pipe.
 All the above lying in Monument Box. Origin and Source of Corner Undermined. Corner is placed Single Proportionment Measurement Between Respective Section Corner. Historical Usage, Documentation and Occupation Agrees With This Corner.

North 64° West	71.30 Feet	10 Inch Jack Pine
North 42° East	61.70 Feet	14 Inch Oak

Found Nail North Side
 Found Nail West Side

POSITION OF SAID
 RECORDED CORNER
 REVIEWED & RATIFIED
 BY MUSKEGON COUNTY
 PEER GROUP IN ACCORDANCE
 WITH P.A. 348, OF 1990

SW 7/1/97


C. Description of monument for corner and accessories established to perpetuate locating the position of the corner:

Replaced All Iron Found In Section "B" and Reset 2 3/4 Inch by 30 Inch Cast Iron Monument With County Surveyor Cap.
 Placed in Monument Box.

North 64° West	71.30 Feet	10 Inch Jack Pine
North 42° East	61.70 Feet	14 Inch Oak
South 38° West	61.74 Feet	10 Inch Jack Pine
North 48° West	41.75 Feet	Power Pole
South 70° East	19.38 Feet	14 Inch White Oak
South 56° East	50.85 Feet	G. Pole
North 49° East	50.76 Feet	G. Pole

Found Nail North Side
 Found Nail West Side
 Found Nail North Side.
 Found Nail Southwest Side
 Set Nail South Side
 Set Nail Northeast Side
 Found Nail West Side

Signed by *Stephen V. Vallier*
 Surveyor's Michigan License No. 28428

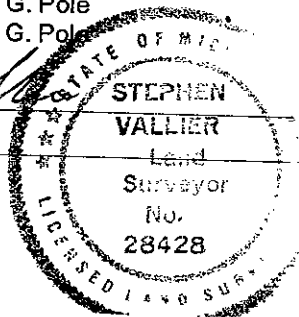

Date December 15, 1997

A1919