

MAR 06 1998

LAND CORNER RECORDATION CERTIFICATE
Filing Requirement of Act 74, Mich. P.A. 1970

STATE OF MICHIGAN
COUNTY OF MUSKEGON
RECORDED

1997 DEC 30 PM 3:22

For corners in SECTION

Table with columns: Muskegon (County), Located In: (10N, 17W), Corner Code # (D-5). Rows include Public Land Survey, Property Controlling in Section, Miscellaneous Property in Sec., Lot No., and Private Claims.

Copy
Carris Carter
REGISTER OF DEEDS

Register of Deeds Stamp & File Number

I, Stephen V. Vallier P.S., in a field survey on November 14, 1997, do hereby certify that under requirements of P.A. 74, Michigan P.A. of 1970, the corner points mentioned in lines 1 and 2 above were in conformance with regulations and rules therefore as required in the current manual of survey instructions of the United States Department of the Interior, Bureau of Land Management or by a decree of a Court of Law and/or that the corner points mentioned in lines 3, 4 and 5 above were in conformance with the rules of the Michigan Board of Land Surveyors or by a Decree of a Court of Law; established, re-established, monumented, re-monumented, recovered, found as expressed below:

Grid table with columns A-M and rows 2-13. A dot is marked at the intersection of column C and row 5.

NOTE: Not more than 4 corners, all in the same town and range, may be recorded on this certificate.

A. Description of original monument and accessories and/or subsequent restoration:

- 1837 Set By G.L.O.
1983 M & B
1713.85 Feet Survey M83305 Distance From South Quarter Corner West to P. I.
1991 RLS - Liber 1567, Page 60 - S. Shackelford
Found 1/2 Inch Iron Rod
South 33° East 54.20 Feet 14 Inch Oak
South 18° West 46.80 Feet 14 Inch Oak
North 30° East 56.37 Feet 16 Inch Oak
North 44° West 60.95 Feet 16 Inch Oak

B. Description of corner evidence found and/or method applied in restoring or reestablishing corner:

Found 1/2 Inch By 30 Inch Square Iron over 4 1/2 Inch By 3 Feet M.D.N.R. Monument.
Note: M.D.N.R. has Been Broken Top Lying Approximately 3 Feet East of 1/2 Inch Square Iron, However, Bottom Position is Aligned With 1/2 Inch Square Iron.
Usage and Known Documentation Verify The Position of This Corner.

POSITION OF SAID
RECORDED CORNER
REVIEWED & RATIFIED
BY MUSKEGON COUNTY
PEER GROUP IN ACCORDANCE
WITH P.A. 345, OF 1990


SW AUG 5 1997

C. Description of monument for corner and accessories established to perpetuate locating the position of the corner:

- Replaced 1/2 Inch By 30 Inch Square Iron with 2 3/4 Inch By 30 Inch Cast Iron Monument with County Surveyor Cap.
South 33° East 54.21 Feet 14 Inch Oak Found Nail on Northeast Side-Blazed
South 18° West 46.84 Feet 16 Inch Oak Found Nail on Southeast Side-Blazed
North 30° East 56.33 Feet 18 Inch Oak Found Nail on Northwest Side
South 50° East 59.98 Feet 18 Inch Oak Found Nail on Northeast Side-Blazed
North 50° West 53.97 Feet 8 Inch Oak Found Nail on Southeast Side
North 13° East 56.24 Feet 10 Inch Pine Set Spike in West Side
North 13° East 29.60 Feet Telephone Riser Centerline

Signed by

Signature of Stephen V. Vallier

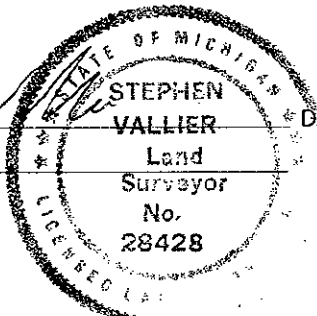

December 15, 1997

Surveyor's Michigan License No. 28428

A1921