

**SURVEY & REMONUMENTATION**

LIBER 1952 PAGE 844

STATE OF MICHIGAN  
COUNTY OF MUSKEGON

MAR 21 1997

**LAND CORNER RECORDATION CERTIFICATE**

BY REC'D 20 11 0:49

**COMMISSION**

Filing Requirement of Act 74, Mich. P.A. 1970

For corners in  
Muskegon  
(County)

Located In:

Corner Code #

- |                                    |                         |       |
|------------------------------------|-------------------------|-------|
| 1. Public Land Survey              | T 10N R 17W             | E-1   |
|                                    | T _____ R _____         | _____ |
|                                    | T _____ R _____         | _____ |
|                                    | T _____ R _____         | _____ |
| 2. Property Controlling in Section | S _____ T _____ R _____ | _____ |
|                                    | S _____ T _____ R _____ | _____ |
| 3. Miscellaneous Property in Sec.  | S _____ T _____ R _____ | _____ |
|                                    | S _____ T _____ R _____ | _____ |

*Carroll*  
REGISTERED

A1858

Register of Deeds Stamp & File Number

4. Lot No. \_\_\_\_\_, Recorded Plat \_\_\_\_\_  
5. Private Claims \_\_\_\_\_

A	B	C	D	E	F	G	H	I	J	K	L
2	6	5	4	3	2	1					
3											
4	7	8	9	10	11	12					
5											
6	18	17	16	15	14	13					
7											
8	19	20	21	22	23	24					
9											
10	30	29	28	27	26	25					
11											
12	31	32	33	34	35	36					
13											

I, Stanley H. Shackelford, P.S. in a field survey on OCTOBER 30, 19 96, do hereby certify that under requirements of P.A. 74, Michigan P.A. of 1970, the corner points mentioned in lines 1 and 2 above were in conformance with regulations and rules therefore as required in the current manual of survey instructions of the United States Department of the Interior, Bureau of Land Management or by a decree of a Court of Law and/or that the corner points mentioned in lines 3, 4 and 5 above were in conformance with the rules of the Michigan Board of Land Surveyors or by a Decree of a Court of Law; established, re-established, monumented, re-monumented, recovered, found as expressed below:

**NOTE: Not more than 4 corners, all in the same town and range, may be recorded on this certificate.**

**A. Description of original monument and accessories and/or subsequent restoration:**

- |   |                |          |               |
|---|----------------|----------|---------------|
| 1837 G.L.O. SET CORNER                                    | SOUTH 16° EAST | 26 LINKS | 8" BLACK OAK  |
|   | SOUTH 38° WEST | 20 LINKS | 6" WHITE OAK  |
| 1950's MUSKEGON COUNTY ROAD COMMISSION FOUND 1½-INCH PIPE | NORTHWEST      | 42.20'   | 12" BLACK OAK |
|   | NORTH          | 36.90'   | 4" PINE       |
|   | NORTHEAST      | 36.60'   | 8" BLACK OAK  |
|   | SOUTHEAST      | 49.00'   | 6" WHITE OAK  |
| ANGLE SOUTH TO WEST 89° 16 MINUTES                        |                |          |               |
| ANGLE SOUTH TO EAST 91° 03 MINUTES                        |                |          |               |
| DISTANCE TO WEST 2652.63'                                 |                |          |               |

"SEE ATTACHED EXHIBIT E-1"

**B. Description of corner evidence found and/or method applied in restoring or reestablishing corner:**

- |  |                |         |                        |             |
|--|----------------|---------|------------------------|-------------|
| FOUND 2¾-INCH X 11-INCH CAST IRON MONUMENT WITH COUNTY SURVEYOR LEGEND IN MONUMENT BOX | NORTH 55° EAST | 69.15'  | 16" OAK                | FOUND SPIKE |
|  | NORTH 55° WEST | 63.32'  | POWER POLE FOUND SPIKE |             |
|  | SOUTH 55° EAST | 56.40'  | GUY POLE FOUND SPIKE   |             |
|  | SOUTH 55° WEST | 121.27' | POWER POLE FOUND SPIKE |             |


CHECKS WITH POSITION OF HISTORICAL USAGE  
CHECKS WITH 1950's DISTANCE TO THE WEST  
CHECKS WITH 1950's ANGLE TO WEST WITHIN 3 MINUTES ±  
CHECKS WITH LIBER 1119, PAGE 400 AND LIBER 1129, PAGE 945 WITNESSES

POSITION OF SAID  
RECORDED CORNER  
REVIEWED & RATIFIED  
BY BOARD OF COUNTY  
SURVEYORS IN ACCORDANCE  
WITH ACT 74, P.A. 1970

*sv*  
*9/10/96*

**C. Description of monument for corner and accessories established to perpetuate locating the position of the corner:**

- |   |                |         |                        |             |
|---|----------------|---------|------------------------|-------------|
| FOUND 2¾-INCH X 11-INCH MONUMENT CAST IRON MONUMENT WITH COUNTY SURVEYOR LEGEND IN MONUMENT BOX | NORTH 55° EAST | 69.15'  | 16" OAK                | FOUND SPIKE |
|   | SOUTH 55° EAST | 56.40'  | GUY POLE               | FOUND SPIKE |
|   | NORTH 55° WEST | 63.32'  | POWER POLE FOUND SPIKE |             |
|   | SOUTH 55° WEST | 121.37' | POWER POLE FOUND SPIKE |             |

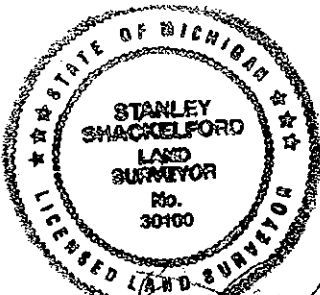

Signed by Stanley H. Shackelford No. 30100 Date 12-26-96

Surveyor's Michigan License No. \_\_\_\_\_

LIBER 1952 PAGE 844

A1858 9

EXHIBIT E-1

LIBER 1952 PAGE 845

1977 LIBER 1119, PAGE 400 BY C.F.L.  
FOUND 1 1/4-INCH PIPE IN MONUMENT BOX

SOUTH 55° EAST	56.40'
SOUTH 55° WEST	121.37'
NORTH 55° WEST	63.32'
NORTH 58° EAST	69.15'

GUY POLE  
POWER POLE  
POWER POLE  
12 INCH WHITE OAK

1977 LIBER 1129, PAGE 945 BY F. SMITH  
FOUND 1-INCH ROD IN MONUMENT BOX

NORTHEAST	69.15'
SOUTHEAST	56.40'
WEST/NORTHWEST	63.60'

SPIKE IN 16 INCH OAK  
SPIKE IN GUY POLE  
SPIKE IN POWER POLE

1984 LIBER 1301, PAGE 577 BY C.F.L.

FOUND 1 1/4-INCH IRON MONUMENT IN MONUMENT BOX

SET 2 1/4" X 11" CAST IRON MONUMENT WITH COUNTY SURVEYOR LEGEND IN MONUMENT BOX

NORTH 55° EAST	69.15'
NORTH 55° WEST	63.32'
SOUTH 55° EAST	56.40'
SOUTH 55° WEST	121.37'

16 INCH OAK  
POWER POLE  
GUY POLE  
POWER POLE