

**SURVEY & REMONUMENTATION**

LIBER 1952 PAGE 846

STATE OF MICHIGAN  
COUNTY OF MUSKEGON  
REGISTER OF DEEDS

**LAND CORNER RECORDATION CERTIFICATE**  
Filing Requirement of Act 74, Mich. P.A. 1970

MAR 21 1997

1997 MAR 30 AM 8:49

For corners in  
Muskegon  
(County)

**COMMISSION**

Located In:

Corner Code #

- |                                    |                           |            |
|------------------------------------|---------------------------|------------|
| 1. Public Land Survey              | T <u>10N</u> R <u>17W</u> | <u>E-2</u> |
|                                    | T _____ R _____           | _____      |
|                                    | T _____ R _____           | _____      |
|                                    | T _____ R _____           | _____      |
| 2. Property Controlling in Section | S _____ T _____ R _____   | _____      |
|                                    | S _____ T _____ R _____   | _____      |
| 3. Miscellaneous Property in Sec.  | S _____ T _____ R _____   | _____      |
|                                    | S _____ T _____ R _____   | _____      |

*Carroll*  
REGISTER OF DEEDS  
11859

Register of Deeds Stamp & File Number

4. Lot No. \_\_\_\_\_, Recorded Plat \_\_\_\_\_  
5. Private Claims \_\_\_\_\_

	A	B	C	D	E	F	G	H	I	J	K	L
2	6		5	4	3	2	1					
3												
4	7	8	9	10	11	12						
5												
6	18	17	16	15	14	13						
7												
8	19	20	21	22	23	24						
9												
10	30	29	28	27	26	25						
11												
12	31	32	33	34	35	36						
13												

I, Stanley H. Shackelford, P.S. in a field survey on October 30, 19 96 do hereby certify that under requirements of P.A. 74, Michigan P.A. of 1970, the corner points mentioned in lines 1 and 2 above were in conformance with regulations and rules therefore as required in the current manual of survey instructions of the United States Department of the Interior, Bureau of Land Management or by a decree of a Court of Law and/or that the corner points mentioned in lines 3, 4 and 5 above were in conformance with the rules of the Michigan Board of Land Surveyors or by a Decree of a Court of Law; established, re-established, monumented, re-monumented, recovered, found as expressed below:

**NOTE: Not more than 4 corners, all in the same town and range, may be recorded on this certificate.**

- A. Description of original monument and accessories and/or subsequent restoration:  
1837 G.L.O. SET CORNER SOUTH 70° EAST 12 LINKS 8" WHITE OAK  
NORTH 77° WEST 13 LINKS 9" WHITE OAK

SEE ATTACHED "EXHIBIT E-2"

- B. Description of corner evidence found and/or method applied in restoring or reestablishing corner:

FOUND 4" X 32" CAST IRON MONUMENT WITH COUNTY SURVEYOR LEGEND IN ASPHALT.

NORTH 45° EAST 52.00' 16" OAK  
NORTH 25° WEST 95.83' 22" MAPLE  
SOUTH 40° EAST 71.15' 16" OAK  
SOUTH 70° WEST 92.56' TO NORTHEAST CORNER HOUSE FOUNDATION

CHECK'S WITH 1950's DISTANCE SOUTH WITHIN 1".  
CHECKS WITH LIBER 1119, PAGE 400, AND LIBER 1129, PAGE 945.

POSITION OF SAID  
RECORDED CORNER  
REVIEWED & CERTIFIED  
BY MUSKEGON COUNTY  
PEER GROUP IN CONFORMANCE  
WITH P.A. 375 OF 1990


9/10/96

LIBER 1952 PAGE 846

- C. Description of monument for corner and accessories established to perpetuate locating the position of the corner:

FOUND 4" X 32" CAST IRON MONUMENT WITH COUNTY SURVEYOR LEGEND IN ASPHALT.

NORTH 45° EAST 52.00' 16" OAK (FOUND SPIKE)  
NORTH 25° WEST 95.83' 22" MAPLE (FOUND SPIKE)  
SOUTH 40° EAST 71.15' 16" OAK (FOUND SPIKE)  
SOUTH 70° WEST 92.56' TO NORTHEAST CORNER HOUSE FOUNDATION

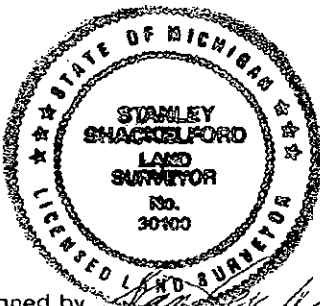

Signed by Stanley H. Shackelford Date 12-26-96  
Surveyor's Michigan License No. 30100

11859