

SURVEY & REMONUMENTATION

LIBER **2052** PAGE **617**

MAR 06 1998

LAND CORNER RECORDATION CERTIFICATE
Filing Requirement of Act 74, Mich. P.A. 1970

STATE OF MICHIGAN
COUNTY OF MUSKEGON
REGISTER OF DEEDS

1997 DEC 30 PM 3:23

Carrie Carter
REGISTER OF DEEDS


For corners in **SECTION**

_____ Muskegon _____ (County)	Located In:	Corner Code #
1. Public Land Survey	TQN <u>17W</u>	E-3
	T _____ R _____	_____
	T _____ R _____	_____
	T _____ R _____	_____
2. Property Controlling in Section	S _____ T _____ R _____	_____
	S _____ T _____ R _____	_____
3. Miscellaneous Property in Sec.	S _____ T _____ R _____	_____
	S _____ T _____ R _____	_____

Register of Deeds Stamp & File Number

4. Lot No. _____, Recorded Plat _____
5. Private Claims _____

I, Stanley H. Shackelford, PS., in a field survey on AUGUST 22, 19 97, do hereby certify that under requirements of P.A. 74, Michigan P.A. of 1970, the corner points mentioned in lines 1 and 2 above were in conformance with regulations and rules therefore as required in the current manual of survey instructions of the United States Department of the Interior, Bureau of Land Management or by a decree of a Court of Law and/or that the corner points mentioned in lines 3, 4 and 5 above were in conformance with the rules of the Michigan Board of Land Surveyors or by a Decree of a Court of Law; established, re-established, monumented, re-monumented, recovered, found as expressed below:

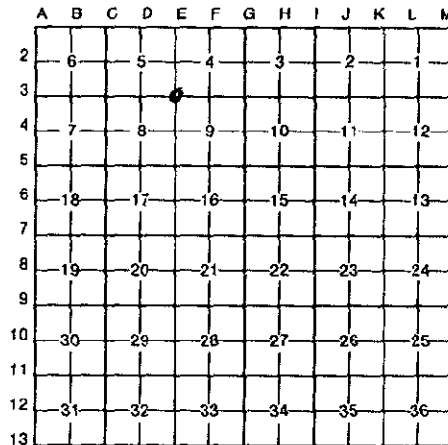

NOTE: Not more than 4 corners, all in the same town and range, may be recorded on this certificate.

A. Description of original monument and accessories and/or subsequent restoration:

GLO Set post June 1, 1837
 South 58° East 15.18 Feet 20 Inch White Oak
 North 23° West 31.20 Feet 20-Inch White Oak
 Liber 1207, Page 644, Recorded by D. Schiele in 1980.
 Found square headed bolt in monument box
 Northeast 74.44 Feet 24-Inch Oak
 South 36.00 Feet Power Pole

(See attached)

B. Description of corner evidence found and/or method applied in restoring or reestablishing corner:


Found 2 3/4 X 21-Inch cast iron monument with county surveyor legend in monument box.
 South 50° East 49.81 Feet Telephone Pole Found Spike Northeast Side
 South 55° West 49.20 Feet Telephone pole Found Spike Northwest Side
 North 40° East 74.50 Feet 26-Inch Oak Found Spike Southwest Side
 North 30° West 63.28 Feet 16-Inch Oak Found Spike Southwest Side
 South 00° West 35.95 Feet Power Pole Found Spike East Side

POSITION OF SAID RECORDED CORNER REVIEWED & RATIFIED BY MUSKEGON COUNTY PEER GROUP IN ACCORDANCE WITH P.A. 345, OF 1990

SVV
11/4/97

C. Description of monument for corner and accessories established to perpetuate locating the position of the corner:

Found 2 3/4 x 21-Inch cast iron monument with county surveyor legend in monument box.
 South 50° East 49.81 Feet Telephone Pole Found Spike Northeast Side
 South 55° West 49.20 Feet Telephone Pole Found Spike Northwest Side
 North 40° East 74.50 Feet 26-Inch Oak Found Spike Southwest Side
 North 30° West 63.28 Feet 16-Inch Oak Found Spike Southwest Side
 South 00° West 35.95 Feet Power Pole Found Spike East Side

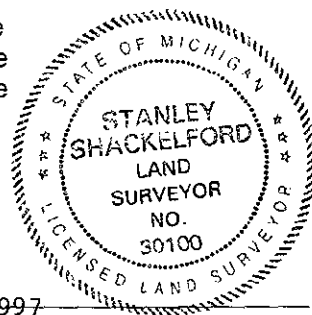

igned by *Stanley H. Shackelford* Date December 15, 1997
 Surveyor's Michigan License No. 30100

A1929

T10N R17W E-3

Southeast	49.81 Feet	Telephone Pole
Northwest	63.20 Feet	14-inch Oak
Liber 1301	Page 580	Recorded by C. Lewandoski in 1984

Found 1-inch square bolt on top of 1-inch square bolt in monument box.
Checks Liber 1207 Page 644

Set 2 3/4-Inch X 21-inch cast iron monument with county surveyor legend in monument box.

South 50° East	49.81 Feet	Telephone Pole
South 55° West	49.20 Feet	Telephone Pole
North 40° East	74.50 Feet	26-inch Oak
North 30° West	63.28 Feet	16-inch Oak

Checks position by Cygrierts Subdivision

SURVEY &
REMONUMENTATION

MAR 06 1998

SECTION