

**SURVEY & REMONUMENTATION**

MAR 06 1998

REC 2050 PAGE 801

LAND CORNER RECORDATION CERTIFICATE  
Filing Requirement of Act 74, Mich. P.A. 1970

STATE OF MICHIGAN  
COUNTY OF MUSKEGON

A1888

1997 DEC 22 PM 3:07

*Carris Carter*  
REGISTER OF DEEDS

Register of Deeds Stamp & File Number

For corners in Muskegon County Section #

1. Public Land Survey	Located in: T <u>10N</u> R <u>17W</u>	Corner Code E-6
	T ___ R ___	_____
	T ___ R ___	_____
	T ___ R ___	_____
2. Property Controlling S ___ T ___ R ___		
in Section	S ___ T ___ R ___	
3. Miscellaneous S ___ T ___ R ___		
Property in Sec. S ___ T ___ R ___		
4. Lot No. ___, Recorded Plat _____		
5. Private Claims _____		

A	B	C	D	E	F	G	H	I	J	K	L	M
2	6	5	4	3	2	1						
3												
4	7	8	9	10	11	12						
5												
6	18	17	16	15	14	13						
7												
8	19	20	21	22	23	24						
9												
10	30	29	28	27	26	25						
11												
12	31	32	33	34	35	36						
13												

I, Donald G. Sandel, in a field survey on July 2, 1997 hereby certify that under requirements of P.A. 74, Michigan P.A. of 1970, the corner points mentioned in lines 1 and 2 above were in conformance with regulations and rules therefore as required in the current manual of survey instructions of the United States Department of the Interior, Bureau of Land Management or by a decree of a Court of Law and/or that the corner points mentioned in lines 3, 4 and 5 above were in conformance with the rules of the Michigan Board of Land Surveyors or by a Decree of a Court of Law; established, re-established, monumented, re-monumented, recovered, found as expressed below:

NOTE: Not more than 4 corners, all in the same town and range, may be recorded on this certificate.

A. Description of original monument and accessories and/or subsequent restoration:

- (1) GLO: Set Quarter section post,  
Pine 24" N40°E 0.20 chains  
Pine 22" N39°W 0.28 chains
- (2) Muskegon County Road Commission:  
SE 47.0' 20" Pine  
WSW 40.25' 16" Oak  
SE 31.0' 18" W.Pine  
SW 39.5' Face of 10" B. Oak  
NW 47.0' 12" B. Oak


POSITION OF SAID  
RECORDED CORNER  
REVIEWED & VERIFIED  
BY MUSKEGON COUNTY  
PEER GROUP, JUNE 17, 1997  
WITH FILE NO. 2050

B. Description of corner evidence found and/or method applied in restoring or reestablishing corner:

- (1) Found Brass Cap Marked "State of Michigan" in a 4" pipe above ground at east edge of trail by wood marker 11-10 and light pole #436. Used Existing witnesses to verify corner location.
- (2) Historical usage, documentation, and evidence of corner location reviewed and ratified by the Muskegon County Peer Group, June 17, 1997.

C. Description of monument for corner and accessories established to perpetuate locating the position of the corner:

- Witnessed Found "State of Michigan" Brass Marker as follows:
- |                        |                          |        |
|------------------------|--------------------------|--------|
| N03°W Set Nail W side  | 17" Oak                  | 40.67' |
| N44°E Set Nail NW side | 1" Oak                   | 24.91' |
| S10°E Set Nail W side  | No Trespassing sign post | 19.0'  |
| S25°W Set Nail W side  | 6" Maple                 | 51.04' |
| S52°W Set Nail SE side | 14" Oak                  | 19.21' |
| N82°W Set Nail S Side  | 8" Oak                   | 53.24' |

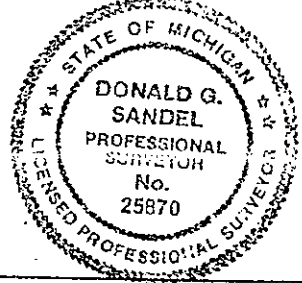

Signed by Donald G. Sandel  
Surveyor's Michigan License No. 25870

Date 5 December 1997

A1888