

SURVEY & REMONUMENTATION

LIBER 2050 PAGE 791

MAR 06 1998

LAND CORNER RECORDATION CERTIFICATE
 Filing Requirement of Act 74, Mich. P.A. 1970

STATE OF MICHIGAN
 COUNTY OF MUSKEGON

A1878

For corners in
 Muskegon County
 # SECTION

Located in: Corner Code

1. Public Land Survey
 T 10N R 17W E-7
 T ___ R ___
 T ___ R ___
 T ___ R ___
2. Property Controlling S ___ T ___ R ___
 in Section S ___ T ___ R ___
3. Miscellaneous S ___ T ___ R ___
 Property in Sec. S ___ T ___ R ___
4. Lot No. ___ Recorded Plat
5. Private Claims

1997 DEC 22 PM 3:05

Carris Carter
 REGISTER OF DEEDS

Register of Deeds Stamp & File Number

A	B	C	D	E	F	G	H	I	J	K	L	M
2	6	5	4	3	2	1						
3												
4	7	8	9	10	11	12						
5												
6	18	17	16	15	14	13						
7												
8	19	20	21	22	23	24						
9												
10	30	29	28	27	26	25						
11												
12	31	32	33	34	35	36						
13												

I, Donald G. Sandel, in a field survey on July 09, 1997, hereby certify that under requirements of P.A. 74, Michigan P.A. of 1970, the corner points mentioned in lines 1 and 2 above were in conformance with regulations and rules therefore as required in the current manual of survey instructions of the United States Department of the Interior, Bureau of Land Management or by a decree of a Court of Law and/or that the corner points mentioned in lines 3, 4 and 5 above were in conformance with the rules of the Michigan Board of Land Surveyors or by a Decree of a Court of Law; established, re-established, monumented, re-monumented, recovered, found as expressed below:

NOTE: Not more than 4 corners, all in the same town and range, may be recorded on this certificate.

A. Description of original monument and accessories and/or subsequent restoration:

- (1) GLO: Set corner post sections 16, 17, 20 & 21
 Pine 10" S 50°E 0.06 chains
 Pine 18" N39°W 0.31 chains
- (2) Certificate of survey by S. Vallier #28428 on 8-19-83, SW corner, found brass cap in 4" pipe:
 S 6" pine 20.3'
 NE 12" Oak 6.70'
 NW 12" Oak 17.60'
- (3) Muskegon County Road Commission: Found State of Michigan cap in 4" pipe
 NW 17.60' 12" Oak
 NE 10.40' 12" Oak
 NE 6.70' 12" Oak
 S 20.3' 6" Pine
 N30°E 26.56' 28" Twin Oak
 S30°W 8.32' 14" Pine

RECORDED OF SAID
 RECORDED CORNER
 REVIEWED & RATIFIED
 BY MUSKEGON COUNTY
 PEER GROUP IN ACCORDANCE
 WITH P.A. 245, OF 1990


B. Description of corner evidence found and/or method applied in restoring or reestablishing corner:

- (1) Found brass cap in 4" pipe approximately 6" above ground marked "State of Michigan". Used existing witness and known distances from nearby "State of Michigan" markers to verify corner location.
- (2) Historical usage, documentation, and evidence of corner location reviewed and ratified by the Muskegon County Peer Group, June 17, 1997.

C. Description of monument for corner and accessories established to perpetuate locating the position of the corner:

Witness found "State of Michigan" brass marker as follows:

N25°E found nail SE side	12" Oak with 3 blazemarks	5.65'
N75°E found nail N side	13" Oak with 3 blazemarks	9.50'
S30°E set nail W side	7" Pine	30.63'
S18°W set nail E side	12" Oak	34.89'
N82°W set nail S side	13" Oak	17.52'
N36°W set nail NE side	8" Oak	13.81'

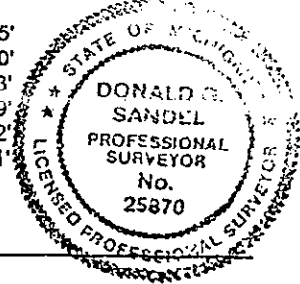

Signed by Donald G. Sandel
 Surveyor's Michigan License No. 25870

Date 5 December 1997

A1878