

# SURVEY & REMONUMENTATION

MAR 06 1998

REF 2050 PAGE 800

## LAND CORNER RECORDATION CERTIFICATE Filing Requirement of Act 74, Mich. P.A. 1970

STATE OF MICHIGAN  
COUNTY OF MUSKEGON

A1857

SECTION  
For corner  
Muskegon County  
#

Located in: Corner Code

1. Public Land Survey T 10N R 17W G-6  
T \_\_\_ R \_\_\_  
T \_\_\_ R \_\_\_  
T \_\_\_ R \_\_\_
2. Property Controlling S \_\_\_ T \_\_\_ R \_\_\_  
In Section S \_\_\_ T \_\_\_ R \_\_\_
3. Miscellaneous S \_\_\_ T \_\_\_ R \_\_\_  
Property in Sec. S \_\_\_ T \_\_\_ R \_\_\_
4. Lot No. \_\_\_ Recorded Plat \_\_\_
5. Private Claims

1997 DEC 02 PM 3:07

*Carlin Carter*  
REGISTER OF DEEDS

Register of Deeds Stamp & File Number

I, Donald G. Sandel, in a field survey on June 27, 1997 hereby certify that under requirements of P.A. 74, Michigan P.A. of 1970, the corner points mentioned in lines 1 and 2 above were in conformance with regulations and rules therefore as required in the current manual of survey instructions of the United States Department of the Interior, Bureau of Land Management or by a decree of a Court of Law and/or that the corner points mentioned in lines 3, 4 and 5 above were in conformance with the rules of the Michigan Board of Land Surveyors or by a Decree of a Court of Law, established, re-established, monumented, re-monumented, recovered, found as expressed below:


A	B	C	D	E	F	G	H	I	J	K	L	M
2	8	5	4	3	2	1						
3												
4	7	8	9	10	11	12						
5												
6	10	17	16	15	14	13						
7												
8	19	20	21	22	23	24						
9												
10	30	29	28	27	26	25						
11												
12	31	32	33	34	35	36						
13												

NOTE: Not more than 4 corners, all in the same town and range, may be recorded on this certificate.

A. Description of original monument and accessories and/or subsequent restoration:

- (1) GLO: Set quarter section st, May 31, 1837.  
B. Oak 16" N82°E chains  
W. Oak 6" N60°W 0.36 chains

- (2) Muskegon County Road Commission; 1 1/4" pipe:
- |       |            |        |
|-------|------------|--------|
| S53°W | Power Pole | 35.12' |
| N65°W | 10" Pine   | 48.85' |
| SE    | 8" Pine    | 86.90' |
| ENE   | 8" Pine    | 55.25' |
| SE    | 24" Oak    | 65.60' |
| SW    | 24" Oak    | 55.94' |

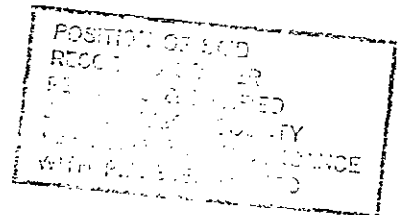

B. Description of corner evidence found and/or method applied in restoring or reestablishing corner:

- (1) Found 1 1/4" pipe 24" long 1.4' East of centerline of Weber Road. Verified corner location using existing witnesses.

- (2) Historical usage, documentation, and evidence of corner location reviewed and ratified by the Muskegon County Peer Group, June 17, 1997.

C. Description of monument for corner and accessories established to perpetuate locating the position of the corner:

- Set 3" D X 31" Cast Iron "County Survey" monument in place of found 1 1/4" pipe; witnessed as follows:  
N54°E, set nail S side, 6" Maple, 38.5'  
S78°E, set nail S side, 12" Maple, 36.22'  
S42°E, found nail SW side, Utility Pole, 37.80'  
S62°W, found nail SE side, Utility Pole, 35.18'  
N73°W, set nail S side, 10" Ash, 47.53'  
N60°W, found nail S side, 10" Spruce, 48.87'

Signed by Donald G. Sandel  
Surveyor's Michigan License No. 25870

Date 5 December 1997

