Survey & REMONUMENTATION

MAR 0 6 1998

1 IRED 2052 PAGE 585

STATE OF MICHIBAL COUNTY OF MUSIFIER A SECTIVES FOR

SECTION

_____, Recorded Plat _

4. Lot No. __

5. Private Claims

LAND CORNER RECORDATION CERTIFICATE Filing Requirement of Act 74, Mich. P.A. 1970

1997	30	7 t	7	10
Car	e (i Vr I

Fo	r corners in	•	,	Post
	Muskegon (County)	Located In:	Corner Code ##	Carres Carl RECISTER OF DIEDS
1.	Public Land Survey	T 10N R 17W T R T R T R	J_2	
2.	Property Controlling in Section	S T R S T R	· 	
3.	Miscellaneous Property in Sec.	S T R S T R		Register of Deeds Stamp & File N

File Number

3

10

t, Ralph W VanRiper, in a field survey onNov. 4	, 19 .9.7
do hereby certify that under requirements of P.A. 74, Michigan P.A. of 1970, the corne	
in lines 1 and 2 above were in conformance with regulations and rules therefore	as required in the
current manual of survey instructions of the United States Department of the Inter	ior, Bureau of Land
Management or by a decree of a Court of Law and/or that the corner points mentions	ed in lines 3, 4 and 5
above were in conformance with the rules of the Michigan Board of Land Surveyors	or by a Decree of a
Court of Law: established re-established monumented re-monumented re-	covered found as

established, re-established, monumented, re-monumented, recovered, found a expressed below: NOTE: Not more than 4 corners, all in the same town and range, may be recorded

on this certificate.

A. Description of original monument and accessories and/or subsequent restoration:

Center of Section 2, Town 10 North, Range 17 West, Laketon Township Not set by GLO Surveyors

B. Description of corner evidence found and/or method applied in restoring or reestablishing corner:

Set 2 3/4" Cast Iron Monument with County Survey Cap at intersection of North-South 1/4 line and East-West 1/4 line



POSITION OF SAID RECORDED CORNER REVIEWED & RATIFIED BY MUSKEGON COUNTY PEER GROUP IN ACCORDANCE WITH P.A. 345, OF 1990

C. Description of monument for corner and accessories established to perpetuate locating the position of the corner:

2 3/4" Cast Iron Monument with County Survey Cap


N 23° E 6.97 Set Spike in SW side of 16" Maple N 82° E 26.04 Set Spike in SW side of 16" Twin Maple

S 33° E 24.31 Set Spike in W side of 10" Ash

S 27° W Set Spike in E side of 16 Triple Maple 3.03

N 53° W 21.77' Set Spike in NE side of 16" Ash

N 27° W Set Spike in SW side of 20" Beach

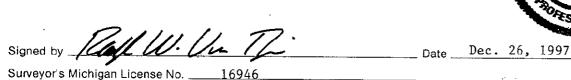



FORM, APPROVED BY MICHIGAN STATE BOARD OF LAND SURVEYORS, JAN. 28, 1971 REVISED MAY 14, 1975 REVISED JAN., 1983

A1906