

**SURVEY & REMONUMENTATION**

LIBER 1952 PAGE 818

MAR 21 1997

COMMISSION

**LAND CORNER RECORDATION CERTIFICATE**  
Filing Requirement of Act 74, Mich. P.A. 1970

STATE OF MICHIGAN  
COUNTY OF MUSKEGON

BY LES 30 13 0:40

*Comptroller*  
MUSKEGON COUNTY

A1845

For corners in  
Muskegon

(County)	Located In:	Corner Code #
1. Public Land Survey	T 10N R 17W	L-1
	T _____ R _____	_____
	T _____ R _____	_____
	T _____ R _____	_____
2. Property Controlling in Section	S _____ T _____ R _____	_____
	S _____ T _____ R _____	_____
3. Miscellaneous Property in Sec.	S _____ T _____ R _____	_____
	S _____ T _____ R _____	_____
4. Lot No. _____, Recorded Plat _____		
5. Private Claims _____		

Register of Deeds Stamp & File Number

I, S. Shackelford, P.S., in a field survey on October 30, 1996, do hereby certify that under requirements of P.A. 74, Michigan P.A. of 1970, the corner points mentioned in lines 1 and 2 above were in conformance with regulations and rules therefore as required in the current manual of survey instructions of the United States Department of the Interior, Bureau of Land Management or by a decree of a Court of Law and/or that the corner points mentioned in lines 3, 4 and 5 above were in conformance with the rules of the Michigan Board of Land Surveyors or by a Decree of a Court of Law; established, re-established, monumented, re-monumented, recovered, found as expressed below:

**NOTE: Not more than 4 corners, all in the same town and range, may be recorded on this certificate.**

A	B	C	D	E	F	G	H	I	J	K	L	M
2	6	5	4	3	2	1						
3												
4	7	8	9	10	11	12						
5												
6	18	17	16	15	14	13						
7												
8	19	20	21	22	23	24						
9												
10	30	29	28	27	26	25						
11												
12	31	32	33	34	35	36						
13												

A. Description of original monument and accessories and/or subsequent restoration:  
 1837 G.L.O. CORNER NOT SET  
 1950's M.C.R.C. CORNER NOT IDENTIFIED  
 NORTH 32.30' TWIN CHERRY  
 SOUTHEAST 64.90' 30" BLACK OAK  
 SOUTHWEST 61.95' 18" WHITE OAK  
 NORTHWEST 42.50' GUY POLE  
 2735.5' DISTANCE EAST  
 2742.4' DISTANCE WEST  
 3999.9' DISTANCE SOUTH

"SEE EXHIBIT L-1"

B. Description of corner evidence found and/or method applied in restoring or reestablishing corner:

FOUND 4" X 32" CAST IRON MONUMENT WITH COUNTY SURVEYOR LEGEND IN ASPHALT  
 NORTH 44° WEST 42.45' GUY POLE FOUND SPIKE  
 SOUTH 37° EAST 96.72' NORTHWEST CORNER HOUSE FOUNDATION  
 SOUTH 44° WEST 44.70' TELEPHONE POLE FOUND SPIKE


CHECKS HISTORICAL POSITION BY USAGE.

CHECK'S 1950's DISTANCE TO EAST

POSITION OF SAID CORNER 8/13/96  
 RECORDED CORNER  
 REVIEWED & RATIFIED  
 BY MUSKEGON COUNTY  
 PEER GROUP IN ACCORDANCE  
 WITH P.A. 315, OF 1970

C. Description of monument for corner and accessories established to perpetuate locating the position of the corner:

FOUND 2 3/4" X 30" CAST IRON MONUMENT WITH COUNTY SURVEYOR LEGEND IN MONUMENT BOX  
 NORTH 44° WEST 42.45' GUY POLE FOUND SPIKE  
 SOUTH 37° EAST 96.72' NORTHWEST CORNER HOUSE FOUNDATION  
 SOUTH 44° WEST 44.70' TELEPHONE POLE FOUND SPIKE

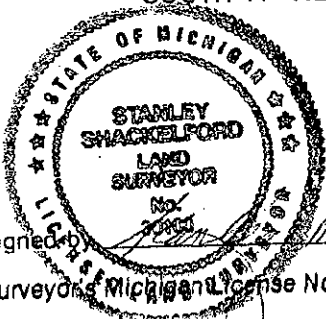

Signed by Stanley Shackelford  
 Surveyor's Michigan License No. 30100

Date 12-26-96

LIBER 1952 PAGE 818

EXHIBIT L-1

LIBER 1952 PAGE 819

1985 LIBER, 1322 PAGE 623 BY C.F.L.

FOUND BOLT SPIKE IN MONUMENT BOX

SET 2 3/4" X 30" CAST IRON MONUMENT WITH COUNTY SURVEYOR LEGEND IN MONUMENT BOX .

NORTH 44° WEST 42.45'

GUY POLE

SOUTH 37° EAST 96.72'

NORTHWEST CORNER HOUSE FOUNDATION

SOUTH 44° WEST 44.70'

TELEPHONE POLE