

SECTION

LAND CORNER RECORDATION CERTIFICATE

APR 28 1990 Filing Requirement of Act 74, Mich. P.A. 1970

STATE OF MICHIGAN
 COUNTY OF MUSKOGON
 RECEIVED
 1997 DEC 30 PM 3: 22

Carrie Carter
 REGISTER OF DEEDS

For corners in

Muskegon

(County)

SECTION

Located In:

Corner Code #

1. Public Land Survey	T	10N	R	17W	G-6
	T		R		
	T		R		
	T		R		
2. Property Controlling in Section	S		T	R	
	S		T	R	
3. Miscellaneous Property in Sec.	S		T	R	
	S		T	R	

Register of Deeds Stamp & File Number

4. Lot No. _____, Recorded Plat _____
 5. Private Claims _____

	A	B	C	D	E	F	G	H	I	J	K	L	M
2	6	5	4	3	2	1							
3													
4	7	8	9	10	11	12							
5													
6	18	17	16	15	14	13							
7													
8	19	20	21	22	23	24							
9													
10	30	29	28	27	26	25							
11													
12	31	32	33	34	35	36							
13													

I, Stephen V. Vallier P.S., in a field survey on November 4, 1997, do hereby certify that under requirements of P.A. 74, Michigan P.A. of 1970, the corner points mentioned in lines 1 and 2 above were in conformance with regulations and rules therefore as required in the current manual of survey instructions of the United States Department of the Interior, Bureau of Land Management or by a decree of a Court of Law and/or that the corner points mentioned in lines 3, 4 and 5 above were in conformance with the rules of the Michigan Board of Land Surveyors or by a Decree of a Court of Law; established, re-established, monumented, re-monumented, recovered, found as expressed below:

NOTE: Not more than 4 corners, all in the same town and range, may be recorded on this certificate.

A. Description of original monument and accessories and/or subsequent restoration:

- 1837 - G.L.O. Set Post - J. Mullett
 South 38° East 24 Links 8 Inch Hemlock
 South 05° West 28 Links 15 Inch Beech
- 1885 No Witnesses - County Survey records - Van Zlingszen. Records do not Indicate if Corner was Set or Found.
- 1950 Plat of Wynwood Subdivision - M. Buck. Northeast Corner of Plat.
- 1960 M.D.O.T. U.S. 31 Alignment Map

(See Attached)

B. Description of corner evidence found and/or method applied in restoring or reestablishing corner:

Found Boot Spike 13 1/2 Inch Long in Monument Box.
 One Feet From Edge of Concrete in Airline Road Exit Ramp
 Evidence Indicates Position of Corner is Perpetuation of G.L.O. Corner as Found in 18985 County Survey Records..

	1997	1885
Northeast Corner to North Quarter (Section 16)	2636.04 Feet	2635.0 Feet
Northeast Corner to Southeast Corner (Section 16)	5320.20 Feet	5398.0 Feet

SVV
11/4/97


POSITION OF SAID
 RECORDED CORNER
 REVIEWED & RATIFIED
 BY MUSKOGON COUNTY
 PEER GROUP IN ACCORDANCE
 WITH P.A. 345, OF 1990

C. Description of monument for corner and accessories established to perpetuate locating the position of the corner

Replaced 13 1/2 Inch Long Boot Spike with 2 3/4 x 30 Inch Cast Iron Monument with County Surveyor Cap in Monument Box.

South 30° West	39.17 Feet	Anchor Bolt	North Side
South 51° East	62.23 Feet	Anchor Bolt	
North 69° West	10.76 Feet	P.K.	Top Wood Guard Rail Post
North 15° West	26.69 Feet	P.K.	Top Wood Guard Rail Post
North 35° West	70.52 Feet	P.K.	Set in Top Wood Guard Rail Post
South 70° East	156.78 Feet	Concrete Monument	
North 39° West	64.47 Feet	12-16 inch Twin Oak	Set Nail in Southwest Side

Signed by *Stephen V. Vallier*
 Surveyor's Michigan License No. 28428

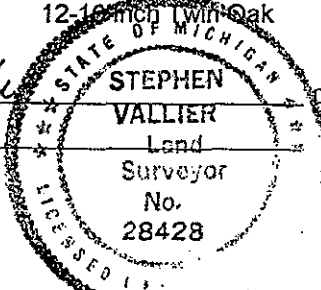

Date December 15, 1997

11918