

**LAND CORNER RECORDATION CERTIFICATE**  
**Filing Requirement of Act 74, Mich. P.A. 1970**

STATE OF MICHIGAN  
 COUNTY OF MUSKEGON  
 RECEIVED FOR RECORD

For corners in

Muskegon Located In: \_\_\_\_\_ Corner Code # \_\_\_\_\_  
 (County)

1. Public Land Survey T 11N R 15W B-10  
 T \_\_\_\_\_ R \_\_\_\_\_  
 T \_\_\_\_\_ R SURVEY &  
 T \_\_\_\_\_ R REMONUMENTATION

2. Property Controlling S \_\_\_\_\_ T \_\_\_\_\_ R \_\_\_\_\_  
 In Section S \_\_\_\_\_ T \_\_\_\_\_ R NOV 28 2000

3. Miscellaneous S \_\_\_\_\_ T \_\_\_\_\_ R \_\_\_\_\_  
 Property in Sec. S \_\_\_\_\_ T \_\_\_\_\_ R \_\_\_\_\_

**SECTION**

4. Lot No. \_\_\_\_\_, Recorded Plat \_\_\_\_\_  
 5. Private Claims \_\_\_\_\_

1998 DEC 28 PM 3:37

*Carrie Carter*  
 REGISTER OF DEEDS  
**LIBER 2189 PAGE 266**

Register of Deeds Stamp & File Number

I, Stephen V. Vallier, in a field survey on December 5, 1998, do hereby state that under requirements of P.A. 74, Michigan P.A. of 1970, the corner points mentioned in lines 1 and 2 above were in conformance with regulations and rules therefore as required in the current manual of survey instructions of the United States Department of the Interior, Bureau of Land Management or by a decree of a Court of Law and /or that the corner points mentioned in lines 3, 4 and 5 above were in conformance with the rules of the Michigan Board of Land Surveyors or by a Decree of a Court of Law; established, re-established, monumented, recovered, found as expressed below:

A	B	C	D	E	F	G	H	I	J	K	L	M
1												
2	6	5	4	3	2	1						
3												
4	7	8	9	10	11	12						
5												
6	18	17	16	15	14	13						
7												
8	19	20	21	22	23	24						
9												
10	●	29	28	27	26	25						
11												
12	31	32	33	34	35	36						
13												

**NOTE:** Not more than 2 corners, all in the same town and range, may be recorded on this certificate.

**A. Description of original monument and accessories and/or subsequent restoration:**

Corner not set by G.L.O.

- 1973 C.F. Lewandowski set 1/2" iron rod at intersection of 1/4 lines.
- 1991 G. Bonney performed boundary survey and accepted corners.
- 1983 C.F. Lewandowski found 1/2" iron rod and reset 4" x 30" cast iron monument without county survey legend. Recorded L.C.R.C. Liber 1264 Page 629

S 80° W                      22.91' 12" oak  
 S 65° E                      18.32' 8" oak  
 S 21° W                      20.15' 10" oak                      N - 33,00' 1/2" iron rod

**B. Description of corner evidence found and/or method applied in restoring or reestablishing corner:**

Found 4" x 30" cast iron monument with county surveyor's cap. No visible occupation. Accepted position of existing corner due to historical usage and documentation. Center of section is at intersection of N-S & E-W 1/4 lines of ratified corners.

S65°E                      18.32' Oak stump                      N - 33.00 1/2" iron rod


*Nov 9 1998*

POSITION OF SAID  
 RECORDED CORNER  
 REVIEWED & RATIFIED  
 BY MUSKEGON COUNTY  
 PEER GROUP IN ACCORDANCE  
 WITH P.A. 345, OF 1990

**C. Description of monument for corner and accessories established to perpetuate locating the position of the corner:**

Found 4" x 30" cast iron monument with county survey cap. Centerline of E-W gravel road - 6" deep.

N90°E                      66.48 - nail south side                      28" oak  
 S45°E                      Quint oak - nail south side                      47.55'  
 N78°W                      28" oak - nail south side                      69.73'  
 N                              1/2" iron rod                                      33.00'  
 S65°E                      8" oak stump                                      18.32

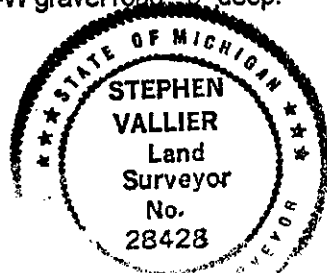

Signed by *Stephen Vallier*  
 Surveyor's Michigan License No. 28428

Date Dec 23, 1998  
 FORM APPROVED BY MICHIGAN STATE BOARD OF PROFESSIONAL SURVEYORS, JAN. 26, 19  
 REVISED MAY 14, 19  
 REVISED JAN., 18  
 REVISED OCT., 19

A 1983