

1998 DEC 28 1999

LAND CORNER RECORDATION CERTIFICATE
 Filing Requirement of Act 74, Mich. P.A. 1970

STATE OF MICHIGAN
 COUNTY OF MUSKEGON
 RECEIVED FOR RECORD

1998 DEC 28 PM 3:38

Carrie Carter
 REGISTER OF DEEDS

LIBER 2189 PAGE 269

Register of Deeds Stamp & File Number

For corners in

SECTION

Muskegon (County)	Located In:	Corner Code #
1. Public Land Survey	T <u>11N</u> R <u>15W</u>	<u>I-8</u>
	T _____ R _____	_____
	T _____ R _____	_____
	T _____ R _____	_____
2. Property Controlling In Section	S _____ T _____ R _____	_____
	S _____ T _____ R _____	_____
3. Miscellaneous Property in Sec.	S _____ T _____ R _____	_____
	S _____ T _____ R _____	_____

4. Lot No. _____, Recorded Plat _____
 5. Private Claims _____

I, Stephen V. Vallier, in a field survey on December 9, 1998, do hereby state that under requirements of P.A. 74, Michigan P.A. of 1970, the corner points mentioned in lines 1 and 2 above were in conformance with regulations and rules therefore as required in the current manual of survey instructions of the United States Department of the Interior, Bureau of Land Management or by a decree of a Court of Law and /or that the corner points mentioned in lines 3, 4 and 5 above were in conformance with the rules of the Michigan Board of Land Surveyors or by a Decree of a Court of Law; established, re-established, monumented, recovered, found as expressed below:

NOTE: Not more than 2 corners, all in the same town and range, may be recorded on this certificate.

A. Description of original monument and accessories and/or subsequent restoration:

1837 G.L.O. set corner post.

S31°E 95 links 10" white oak
 N86°W 1.15 links 23" pine

1940 T. Norlin iron

NW 51.83' 16" pine
 SW 70.58' 12" tri pine
 NE 54.70' 12" oak

1989 Stan Shackelford found iron pipe reset with 4" x 30" cast iron monument with county surveyor's cap. Recorded in L.C.R.C. in Liber 1502 Page 551.

N65°W 51.83' 16" pine
 S66°W 70.58' 12" tri pine
 N42°E 54.70' 12" oak
 S84°E 54.17' 8" oak

*Nov 24, 1998
 SV*

POSITION OF SAID
 RECORDED CORNER
 REVIEWED & RATIFIED
 BY MUSKEGON COUNTY
 PEER GROUP IN ACCORDANCE
 WITH P.A. 345, OF 1990

	A	B	C	D	E	F	G	H	I	J	K	L	M
1													
2	6		5		4		3		2		1		
3													
4	7		8		9		10		11		12		
5													
6	18		17		16		15		14		13		
7													
8	19		20		21		22		23		24		
9													
10	30		29		28		27		26		25		
11													
12	31		32		33		34		35		36		
13													


B. Description of corner evidence found and/or method applied in restoring or reestablishing corner.

Found 4" x 30" cast iron monument with county surveyor's cap. Witnesses check L.C.R.C. Liber 1502 Page 551. Found corner is on line and single proportionate for mile measure. No visible occupation or G.L.O. evidence. Accepted position of corner due to historical usage and documentation.

C. Description of monument for corner and accessories established to perpetuate locating the position of the corner.

Found 4" x 30" cast iron monument with county surveyor's cap. Corner in centerline of north-south two-track road

N65°W 51.83' 16" pine - nail north side
 S66°W 70.58' 12" tri pine - nail east side
 N42°E 54.70' 12" oak - nail east side
 S84°E 54.17' 8" oak - nail north side
 W 12.60' 12" oak - nail south side
 N80°E 11.09' 8" oak - nail south side
 S80°E 34.00' 12" oak - nail north side

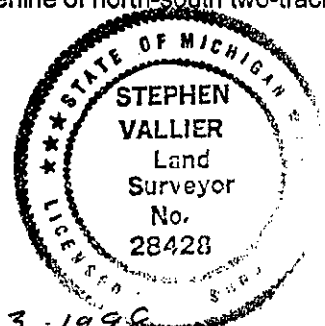

Signed by *Stephen V. Vallier*
 Surveyor's Michigan License No. 28428

Date Dec 23, 1998
 FORM APPROVED BY MICHIGAN STATE BOARD OF PROFESSIONAL SURVEYORS, JAN. 28, 19
 REVISED MAY 14, 19
 REVISED JAN. 19
 REVISED OCT. 19

A 1986