

LAND CORNER RECORDATION CERTIFICATE
Filing Requirement of Act 74, Mich. P.A. 1970

For corners in
Muskegon County

Located in: Corner Code #

- 1. Public Land Survey T 11N R 16W B-1 *SA #1*
- 2. Property Controlling S _____ T _____ R _____
- In Section S _____ T _____ R _____
- 3. Miscellaneous S _____ T _____ R _____
- Property in Sec. S _____ T _____ R _____
- 4. Lot No _____, Recorded Plat _____
- 5. Private Claims _____

SURVEY &
REMONUMENTATION Register of Deeds Stamp & File Number


APR 04 1996

COMMISSION

	A	B	C	D	E	F	G	H	I	J	K	L	M
2	6	5	4	3	2	1							
3													
4	7	8	9	10	11	12							
5													
6	18	17	16	15	14	13							
7													
8	19	20	21	22	23	24							
9													
10	30	29	28	27	26	25							
11													
12	31	32	33	34	35	36							
13													

I, Donald G. Sandel, in a field survey on Nov. 25, 1995 hereby certify that under requirements of P.A. 74, Michigan P.A. of 1970, the corner points mentioned in lines 1 and 2 above were in conformance with regulations and rules therefore as required in the current manual of survey instructions of the United States Department of the Interior, Bureau of Land Management or by a decree of a Court of Law and/or that the corner points mentioned in lines 3, 4 and 5 above were in conformance with the rules of the Michigan Board of Land Surveyors or by a Decree of a Court of Law; established, re-established, monumented, re-monumented, recovered, found as expressed below:

NOTE: Not more than 4 corners, all in the same town and range, may be recorded on this certificate.

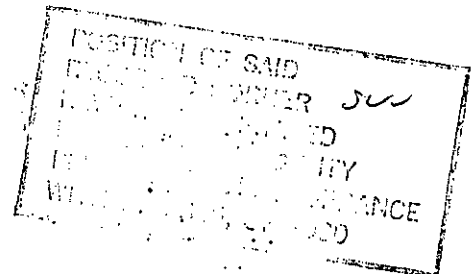

- A. Description of original monument and accessories and/or subsequent restoration:
 - (1) Corner not set by GLO Survey.
 - (2) MCRC (1950's): no witnesses found on record.
 - (3) No other witnesses found on record or obtained at Peer Group Review and Ratification March 7, 1995.
 - (4) Corner referenced to NE Corner Lakewood Addition No. 5, Plat HE/ NW Corner Lakewood Addition No. 5, Plat HF.
- B. Description of corner evidence found and/or method applied in restoring or reestablishing corner:
 - (1) Found Railroad spike at approximate centerline of White Lake Drive.
 - (2) Historical usage, documentation, and evidence of corner location reviewed and ratified by the Muskegon County Peer Group, March 7, 1995.
- C. Description of monument for corner and accessories established to perpetuate locating the position of the corner:
 - Set 2 3/4" D Cast Iron "County Survey" monument in place of found Railroad spike; witnessed as follows:
 - N52°W, found nail, 6" Pine, 79.28'
 - North, set nail, 26" Oak, 43.84'
 - S41°E, found nail, 8" Red Pine, 68.30'
 - South, found nail, 14" Oak, 44.74'
 - S39°W, set nail, 12" Oak, 55.63'
 - N10°W, set nail E side, Sign Pole, 37.95'



Signed by Donald G. Sandel
Surveyor's Michigan License No. 25870

Date 5 December 1995