

RECORDED
INDEXED
NOV 15 1995

LAND CORNER RECORDATION CERTIFICATE
Filing Requirement of Act 74, Mich. P.A. 1970

For corners in
Muskegon
(County)

Located In: Corner Code //

- 1. Public Land Survey T 11N R 16W B 2
- 2. Property Controlling S T R
- 3. Miscellaneous S T R
- Property in Sec. S T R

**SURVEY &
REMONUMENTATION**

APR 04 1996

Register of Deeds Stamp & File Number

COMMISSION

- 4. Lot No. _____, Recorded Plat _____
- 5. Private Claims _____

	A	B	C	D	E	F	G	H	I	J	K	L
2				5	4	3	2	1				
3												
4	7	8	9	10	11	12						
5												
6	18	17	16	15	14	13						
7												
8	19	20	21	22	23	24						
9												
10	30	29	28	27	26	25						
11												
12	31	32	33	34	35	36						
13												

I, Ralph W. VanRiper, in a field survey on Dec. 5, 1995

do hereby certify that under requirements of P.A. 74, Michigan P.A. of 1970, the corner points mentioned in lines 1 and 2 above were in conformance with regulations and rules therefore as required in the current manual of survey instructions of the United States Department of the Interior, Bureau of Land Management or by a decree of a Court of Law and/or that the corner points mentioned in lines 3, 4 and 5 above were in conformance with the rules of the Michigan Board of Land Surveyors or by a Decree of a Court of Law; established, re-established, monumented, re-monumented, recovered, found as expressed below:

NOTE: Not more than 4 corners, all in the same town and range, may be recorded on this certificate.

A. Description of original monument and accessories and/or subsequent restoration:

Center of Section 6, T 11 N, R 16 W, Dalton Township

Not set by GLO Surveyors

B. Description of corner evidence found and/or method applied in restoring or reestablishing corner:

Found 1" Pipe, no witness in Muskegon County Road Commission Witness Book. Corner found is at the intersection of Ashland Street and Violet Way as shown on Plats of Lakewood, Lakewood No. 5 and Lakewood No. 8.


POSITION FOUND
RECORDED
REMONUMENTED
BY LAND SURVEYOR
BEING FOUND IN CONFORMANCE
WITH P.A. 74, OF 1970

11/13/95

C. Description of monument for corner and accessories established to perpetuate locating the position of the corner:

Set 2 3/4" Cast Iron Monument with County Surveyors Cap.

- N 50° E 40.58' Set spike in N side of 16" Oak
- N 79° E 25.20' Set spike in N side of 8" Oak
- S 77° E 33.38' Set spike in SW side of 20" Oak
- S 50° E 11.69' Set spike in W side of 10" Oak
- S 52° W 13.12' Set spike in N side of 18" Oak
- N 6° W 25.61' Set spike in W side of 12" Oak

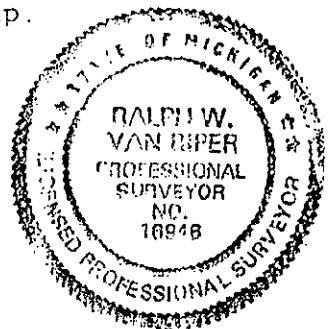

Signed by Ralph W. VanRiper

Date Dec. 19, 1995

Surveyor's Michigan License No. 16946