

LAND CORNER RECORDATION CERTIFICATE  
Filing Requirement of Act 74, Mich. P.A. 1970

For corners in  
Muskegon  
(County)

Located In: \_\_\_\_\_ Corner Code: 11

- 1. Public Land Survey T 11N R 16W
- T \_\_\_\_\_ R \_\_\_\_\_
- T \_\_\_\_\_ R \_\_\_\_\_
- T \_\_\_\_\_ R \_\_\_\_\_
- 2. Property Controlling S \_\_\_\_\_ T \_\_\_\_\_ R \_\_\_\_\_
- in Section S \_\_\_\_\_ T \_\_\_\_\_ R \_\_\_\_\_
- 3. Miscellaneous S \_\_\_\_\_ T \_\_\_\_\_ R \_\_\_\_\_
- Property in Sec. S \_\_\_\_\_ T \_\_\_\_\_ R \_\_\_\_\_

**SURVEY &  
REMONUMENTATION**

APR 04 1996

**COMMISSION**

Register of Deeds Stamp & File Number

- 4. Lot No. \_\_\_\_\_, Recorded Plat \_\_\_\_\_
- 5. Private Claims \_\_\_\_\_

	A	B	C	D	E	F	G	H	I	J	K	L
2	6		5		4		3		2			
3												
4	7		8		9		10		11			
5												
6	18		17		16		15		14			
7												
8	19		20		21		22		23			
9												
10	30		29		28		27		26			
11												
12	31		32		33		34		35			
13												

Ralph W VanRiper

July 11 1995

I, Ralph W VanRiper, in a field survey on July 11, 1995 do hereby certify that under requirements of P.A. 74, Michigan P.A. of 1970, the corner points mentioned in lines 1 and 2 above were in conformance with regulations and rules therefore as required in the current manual of survey instructions of the United States Department of the Interior, Bureau of Land Management or by a decree of a Court of Law and/or that the corner points mentioned in lines 3, 4 and 5 above were in conformance with the rules of the Michigan Board of Land Surveyors or by a Decree of a Court of Law; established, re-established, monumented, re-monumented, recovered, found as expressed below:


NOTE: Not more than 4 corners, all in the same town and range, may be recorded on this certificate.

A. Description of original monument and accessories and/or subsequent restoration:

1/4 Corner common to Sections 18 and 19, T 11 N, R 16 W, Dalton Township  
Post set by GLO Surveyors in 1837 (Hemlock 10", S 40° W, 17L)  
(Hemlock 10", N 64° W, 04L)  
MCRC (1950's) 3 Witnesses to Corner  
MCRC Witness Book, 3/4" Iron with 8 Witnesses

B. Description of corner evidence found and/or method applied in restoring or reestablishing corner:

Found 1/2 Pipe in Asphalt pavement of Riley-Thompson Road  
Verified corner location with existing witnesses.

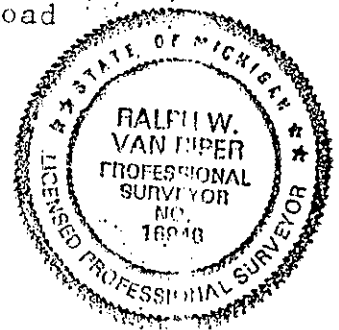

C. Description of monument for corner and accessories established to perpetuate locating the position of the corner:

Set 2 3/4" Cast Iron Monument with County Survey Cap in Asphalt Pavement

- N 23° E 50.31' Found Spike in N side of Tel. Pole
- N 48° E 61.20' Set Spike in NW side of 12" Maple
- S 10° E 74.25' NE corner of Garage foundation
- S 51° W 107.69' NW corner of House foundation
- S 58° W 73.62' Set Spike in N side of 16" Pine
- N 25° W 58.00' Found Spike in SW side of Twin 14" Pine

Signed by Ralph W. VanRiper

Date Dec. 19, 1995

Surveyor's Michigan License No. 16946