

LAND CORNER RECORDATION CERTIFICATE
Filing Requirement of Act 74, Mich. P.A. 1970

For corners in

Muskegon
(County)

Located In:

Corner Code #1

1. Public Land Survey

T 11N R 16W

B 8

2. Property Controlling
in Section

S T R

3. Miscellaneous
Property in Sec.

S T R
S T R

SURVEY &
REMONUMENTATION

APR 04 1996

Register of Deeds Stamp & File Number

4. Lot No. _____, Recorded Plat _____

5. Private Claims _____

COMMISSION

	A	B	C	D	E	F	G	H	I	J	K	L
2	6	5	4	3	2							
3												
4	7	8	9	10	11							
5												
6	18	17	16	15	14	13						
7												
8	19	20	21	22	23	24						
9												
10	30	29	28	27	26	25						
11												
12	31	32	33	34	35	36						
13												

I, Ralph W VanRiper in a field survey on July 11 19 95

do hereby certify that under requirements of P.A. 74, Michigan P.A. of 1970, the corner points mentioned in lines 1 and 2 above were in conformance with regulations and rules therefore as required in the current manual of survey instructions of the United States Department of the Interior, Bureau of Land Management or by a decree of a Court of Law and/or that the corner points mentioned in lines 3, 4 and 5 above were in conformance with the rules of the Michigan Board of Land Surveyors or by a Decree of a Court of Law; established, re-established, monumented, re-monumented, recovered, found as expressed below:

NOTE: Not more than 4 corners, all in the same town and range, may be recorded on this certificate.


A. Description of original monument and accessories and/or subsequent restoration:

Center of Section 19, T 11 N, R 16 W, Dalton Township
Not set by GLO Surveyors

MCRC (1950's) Nothing shown at corner
MCRC Witness Book, Pipe with 4 Witnesses

B. Description of corner evidence found and/or method applied in restoring or reestablishing corner:

Found 1" Pipe with 90° Elbow, Verified corner location
with existing witnesses.

 

C. Description of monument for corner and accessories established to perpetuate locating the position of the corner:

Set 2 3/4" Cast Iron Monument with County Survey Cap

- N 20° E 27.72' Set Spike in NW side of 6" Oak
- N 75° E 12.16' Found Spike in S side of Wood Fence Post
- S 22° E 24.21' Found Spike in NE side of 12" Oak
- S 5° W 17.83' Found Spike in W side of 8" Sass.
- N 70° W 10.16' Found Spike in N side of 30" Oak
- N 30° W 4.54' Found Spike in E side of 6" Sass.



Signed by Ralph W. Van Riper

Date Dec. 19, 1995

Surveyor's Michigan License No. 16946