

LAND CORNER RECORDATION CERTIFICATE
Filing Requirement of Act 74, Mich. P.A. 1970

For corners in
Muskegon County

Located in: Corner Code #

- 1. Public Land Survey T 11N R 16W C-3
- T _____ R _____
- T _____ R _____
- T _____ R _____
- 2. Property Controlling S _____ T _____ R _____ SURVEY &
- In Section S _____ T _____ R _____ REMONUMENTATION
- 3. Miscellaneous S _____ T _____ R _____
- Property in Sec. S _____ T _____ R _____

- 4. Lot No _____, Recorded Plat _____
- 5. Private Claims _____

APR 04 1996

COMMISSION

STATE OF MICHIGAN
 COUNTY OF MUSKEGON
 REGISTER OF DEEDS
 1995 DEC 12 AM 11:42
 Register of Deeds Stamp & File Number

I, Donald G. Sandel, in a field survey on Nov. 21, 1995 hereby certify that under requirements of P.A. 74, Michigan P.A. of 1970, the corner points mentioned in lines 1 and 2 above were in conformance with regulations and rules therefore as required in the current manual of survey instructions of the United States Department of the Interior, Bureau of Land Management or by a decree of a Court of Law and/or that the corner points mentioned in lines 3, 4 and 5 above were in conformance with the rules of the Michigan Board of Land Surveyors or by a Decree of a Court of Law; established, re-established, monumented, re-monumented, recovered, found as expressed below:

NOTE: Not more than 4 corners, all in the same town and range, may be recorded on this certificate.


	A	B	C	D	E	F	G	H	I	J	K	L	M
2	6	5	4	3	2	1							
3		8	9	10	11	12							
4	7												
5													
6	18	17	16	15	14	13							
7													
8	19	20	21	22	23	24							
9													
10	30	29	28	27	26	25							
11													
12	31	32	33	34	35	36							
13													

POSITION OF SAID
RECORDED CORNER
DELETED & RATHED
BY _____ COUNTY
PEER GROUP, DISTANCE
W/ 11/21/95, OF 1990

- A. Description of original monument and accessories and/or subsequent restoration:
- (1) GLO: Set post corners Section 5,6,7 & 8
Spruce 10" S35°E, .11 Chains
Spruce 11" N45°W, .20 Chains
 - (2) MCRC (1950's): 15" B. Oak WNW 73.60', 10" W. Oak WSW 68.75', 15" W. Oak ESE 81.20'
 - (3) Recorded 1/2" rerod at intersection Lakewood and Automobile Road. D. sandel; Liber 1046, Page 745.
N48°E, 8" Jack Pine 63.88'
S61°W, Utility Pole, 40.44'
S35°E, 10" Jack Pine, 55.98'
N24°W, 11" B. Oak, 69.48'

- B. Description of corner evidence found and/or method applied in restoring or reestablishing corner:
- (1) Found 3/4" X 6" pipe inside 1 1/2" X 25" pipe in gravel at intersection of Lakewood and Automobile Road. Used existing witnesses to verify corner location.
 - (2) Historical usage, documentation, and evidence of corner location reviewed and ratified by the Muskegon County Peer Group, March 7, 1995.

- C. Description of monument for corner and accessories established to perpetuate locating the position of the corner:
- Set 2 3/4" X 30" Cast Iron "County Survey" monument in place of found 3/4" & 1 1/2" pipe; witnessed as follows:
- S64°W, set nail in Power Pole, 40.40'
 - N62°W, found nail, 24" Oak, 73.71'
 - N51°E, set nail, 8" Pine, 63.84'
 - N63°E, found nail, 8" Pine, 68.59'
 - S55°E, set nail, 24" Oak, 83.66'
 - S 23°E, found nail, 8" Oak, 68.00'

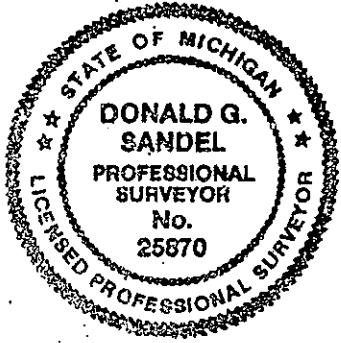

Signed by Donald G. Sandel Date 5 December 1995
Surveyor's Michigan License No. 25870