

81871 Pg. 595

A1721

LAND CORNER RECORDATION CERTIFICATE
Filing Requirement of Act 74, Mich. P.A. 1970

For corners in
Muskegon
(County)

Located In: Corner Code #

- 1. Public Land Survey T 11N R 16W C-4
- T _____ R _____
- T _____ R _____
- T _____ R _____
- 2. Property Controlling S _____ T _____ R _____
- in Section S _____ T _____ R _____
- 3. Miscellaneous S _____ T _____ R _____
- Property in Sec. S _____ T _____ R _____


**SURVEY &
REMONUMENTATION**
APR 04 1996

STATE OF MICHIGAN
COUNTY OF MUSKEGON
REGISTERED
1995 FEB 18 PM 4:13

Register of Deeds Stamp & File Number

- 4. Lot No. _____, Recorded Plat _____
- 5. Private Claims _____

COMMISSION

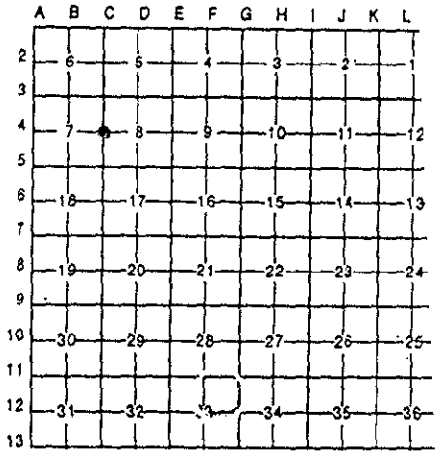

I, Stephen V. Vallier, P.S., in a field survey on September 21, 1995, do hereby certify that under requirements of P.A. 74, Michigan P.A. of 1970, the corner points mentioned in lines 1 and 2 above were in conformance with regulations and rules therefore as required in the current manual of survey instructions of the United States Department of the Interior, Bureau of Land Management or by a decree of a Court of Law and/or that the corner points mentioned in lines 3, 4 and 5 above were in conformance with the rules of the Michigan Board of Land Surveyors or by a Decree of a Court of Law; established, re-established, monumented, re-monumented, recovered, found as expressed below:

NOTE: Not more than 4 corners, all in the same town and range, may be recorded on this certificate.

A. Description of original monument and accessories and/or subsequent restoration:

- 1837 GLO set corner S 50 deg. W 23 Links 10" Spruce
- 1915 T. Norlin corner tied to Plat of Lakewood
- 1974 F. Smith found 1/2" Steel Rod
- SW 67.65' 16" Oak (nail)
- SE 51.00' Twin 10" Oak (nail)
- NE 30.80' 10" Oak (nail)

(see Exhibit "A")

B. Description of corner evidence found and/or method applied in restoring or reestablishing corner:

Found 4" x 30" Cast Iron Monument with County Survey Cap. Check witnesses of LCRC Liber 1604 Page 927 and LCRC Liber 1458 Page 293.

POSITION OF SAID
RECORDED CORNER
REVIEWED & RATIFIED
BY MUSKEGON COUNTY
PEER GROUP IN ACCORDANCE
WITH P.A. 345, OF 1990

Nov 13, 1995

C. Description of monument for corner and accessories established to perpetuate locating the position of the corner:

- Found 4" x 30" Cast Iron Monument with County Survey Cap.
- N 66 deg. E 30.80' 12" Oak (nail)
- S 45 deg. E 51.00' Twin Oak (nail)
- S 31 deg. W 67.65' 18" Oak (nail)
- N 72 deg. W 34.38' 16" Oak (nail)
- AZ 132 deg. 51.04' 16" White Oak (nail SW side)
- AZ 67 deg. 30.76' 12" Black Oak (nail S side)
- AZ 212 deg. 67.59' 14" White Oak (nail W side)
- AZ 284 deg. 34.38' 15" White Oak (nail S side)



Signed by Stephen V. Vallier
Surveyor's Michigan License No. 28428

Date Dec 15, 1995