

L 1871 Pg. 597

A1722

LAND CORNER RECORDATION CERTIFICATE  
Filing Requirement of Act 74, Mich. P.A. 1970

For corners in  
**Muskegon**  
(County)

Located In: Corner Code #

1. Public Land Survey	T	11N	R	16W	C-5
	T		R		
	T		R		
	T		R		
	T		R		
2. Property Controlling in Section	S		T		
	S		T		
3. Miscellaneous Property in Sec.	S		T		
	S		T		

**SURVEY &  
REMONUMENTATION**

**NOV 28 2000**

**SECTION**


STATE OF MICHIGAN  
 COUNTY OF MUSKEGON  
 REGISTER OF DEEDS  
 NOV 13 1995 PM 4:13

Register of Deeds Stamp & File Number

4. Lot No. \_\_\_\_\_, Recorded Plat \_\_\_\_\_

5. Private Claims \_\_\_\_\_

I, Stephen V. Vallier, P.S., in a field survey on September 21, 1995, do hereby certify that under requirements of P.A. 74, Michigan P.A. of 1970, the corner points mentioned in lines 1 and 2 above were in conformance with regulations and rules therefore as required in the current manual of survey instructions of the United States Department of the Interior, Bureau of Land Management or by a decree of a Court of Law and/or that the corner points mentioned in lines 3, 4 and 5 above were in conformance with the rules of the Michigan Board of Land Surveyors or by a Decree of a Court of Law; established, re-established, monumented, re-monumented, recovered, found as expressed below:

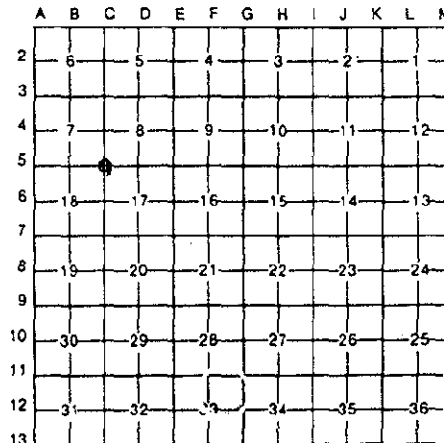

**NOTE: Not more than 4 corners, all in the same town and range, may be recorded on this certificate.**

A. Description of original monument and accessories and/or subsequent restoration:

1837 GLO set corner  
 1950's MCRC - 1" Iron Pipe

NW	86.30'	10" White Oak
NW	67.09'	22" Oak
SE	67.20'	16" Black Oak
SSW	79.87'	20" Oak
SW	63.00'	Twin Black Oak

(see Exhibit "A")

B. Description of corner evidence found and/or method applied in restoring or reestablishing corner:

Found 4" x 30" Cast Iron Monument with County Survey Cap. Corner is approximate centerline gravel road North and South extended and 11' South of centerline of East-West gravel road. Corner checks witnesses of LCRC Liber 1550 Page 124 and checks Lakewood Plats.

POSITION OF SAID  
 RECORDED CORNER  
 REVIEWED & RATIFIED  
 BY MUSKEGON COUNTY  
 PEER GROUP IN ACCORDANCE  
 WITH P.A. 345, OF 1990

Nov. 13, 1995 SVV

C. Description of monument for corner and accessories established to perpetuate locating the position of the corner:

Found 4" x 30" Cast Iron Monument with County Survey Cap.

N 27 deg. W	85.40'	16" White Pine (nail)
S 72 deg. W	62.57'	24" Twin Oak (nail)
N 60 deg. W	67.00'	22" Oak (nail)
S 15 deg. W	76.83'	20" Oak (nail)
S 70 deg' E	35.63'	30" Oak (nail)
N 30 deg. E	76.25'	14" Red Pine (nail)



Signed by Stephen V. Vallier Date Dec 15, 1995

Surveyor's Michigan License No. 28428