

APR 04 1996

COMMISSION

LAND CORNER RECORDATION CERTIFICATE
Filing Requirement of Act 74, Mich. P.A. 1970

For corners in
Muskegon
(County)

Located In: Corner Code #/

- | | | |
|---------------------------------------|-------------------------|-------|
| 1. Public Land Survey | T 11N R 16W | C 8 |
| | T _____ R _____ | _____ |
| | T _____ R _____ | _____ |
| | T _____ R _____ | _____ |
| 2. Property Controlling in Section | S _____ T _____ R _____ | _____ |
| | S _____ T _____ R _____ | _____ |
| 3. Miscellaneous Property in Sec. | S _____ T _____ R _____ | _____ |
| | S _____ T _____ R _____ | _____ |
| 4. Lot No. _____, Recorded Plat _____ | | |
| 5. Private Claims _____ | | |

Register of Deeds Stamp & File Number

A	B	C	D	E	F	G	H	I	J	K	L
2	6	5	4	3	2						
3											
4	7	8	9	10	11						
5											
6	18	17	16	15	14						
7											
8	19	20	21	22	23						
9											
10	30	29	28	27	26						
11											
12	31	32	33	34	35						
13											


I, _____ in a field survey on _____, 19____ do hereby certify that under requirements of P.A. 74, Michigan P.A. of 1970, the corner points mentioned in lines 1 and 2 above were in conformance with regulations and rules therefore as required in the current manual of survey instructions of the United States Department of the Interior, Bureau of Land Management or by a decree of a Court of Law and/or that the corner points mentioned in lines 3, 4 and 5 above were in conformance with the rules of the Michigan Board of Land Surveyors or by a Decree of a Court of Law; established, re-established, monumented, re-monumented, recovered, found as expressed below:

NOTE: Not more than 4 corners, all in the same town and range, may be recorded on this certificate.

A. Description of original monument and accessories and/or subsequent restoration:
1/4 Corner between Sections 19 and 20, T 11 N, R 16 W, Dalton Township
Post set by GLO Surveyors in 1837 (Beech 9", S 18" W, 20L)
(Maple 8", N 13" W, 16L)
MCRC (1950's) Iron Pipe with 3 Witnesses
MCRC Witness Book, Bolt (RR Spike) with 3 Witnesses, Corner recorded in
Liber 1057, Page 144, by Francis F. Smith, RLS No. 3538 in March of 1975

B. Description of corner evidence found and/or method applied in restoring or reestablishing corner:
Found Bolt over 1" Pipe in Asphalt pavement - Automobile Road
Verified corner location with existing witnesses.

POSITION OF S.
RECORDED
REVIEWED
DATE
BY
NO. 105

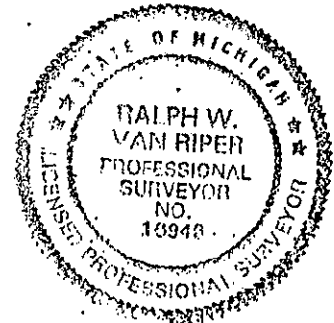

C. Description of monument for corner and accessories established to perpetuate locating the position of the corner:
Set 2 3/4" Cast Iron Monument with County survey Cap in Asphalt pavement.
N 23° E 75.22' Set Spike in W side of 30" Oak
N 37° E 48.82' Found Spike in NW side of 18" Oak
N 73° E 79.41' Found Spike in S side of 36" Maple
S 32° W 52.61' Found Spike in N side of 36" Maple
S 70° W 30.10' Set Spike in N side of 22" Pine
S 88° W 39.22' Found Spike in S side of Utility Pole

Signed by Ralph W. Van Riper
Surveyor's Michigan License No. 16946

Date Dec. 19, 1995