

**SURVEY &  
REMONUMENTATION**

LIBER **1810** PAGE **621**

STATE OF MICHIGAN  
COUNTY OF MUSKEGON  
RECEIVED FOR RECORD

APR 28 1995

1994 DEC 29 AM 10:18

**COMMISSION**

**LAND CORNER RECORDATION CERTIFICATE**  
Filing Requirement of Act 74, Mich. P.A. 1970

*Carrie Carter*  
REGISTER OF DEEDS

For corners in

<u>Muskegon</u> (County)	Located In:	Corner Code #
1. Public Land Survey	T <u>11N</u> R <u>16W</u>	<u>E 1</u>
	T _____ R _____	_____
	T _____ R _____	_____
	T _____ R _____	_____
2. Property Controlling in Section	S _____ T _____ R _____	_____
	S _____ T _____ R _____	_____
3. Miscellaneous Property in Sec.	S _____ T _____ R _____	_____
	S _____ T _____ R _____	_____

*A1645*

Register of Deeds Stamp & File Number

4. Lot No. \_\_\_\_\_, Recorded Plat \_\_\_\_\_  
5. Private Claims \_\_\_\_\_

I, Ralph W. VanRiper, in a field survey on June 30, 19 94, do hereby certify that under requirements of P.A. 74, Michigan P.A. of 1970, the corner points mentioned in lines 1 and 2 above were in conformance with regulations and rules therefore as required in the current manual of survey instructions of the United States Department of the Interior, Bureau of Land Management or by a decree of a Court of Law and/or that the corner points mentioned in lines 3, 4 and 5 above were in conformance with the rules of the Michigan Board of Land Surveyors or by a Decree of a Court of Law; established, re-established, monumented, re-monumented, recovered, found as expressed below:

	A	B	C	D	E	F	G	H	I	J	K	L	M
2	6	5	4	3	2	1							
3													
4	7	8	9	10	11	12							
5													
6	18	17	16	15	14	13							
7													
8	19	20	21	22	23	24							
9													
10	30	29	28	27	26	25							
11													
12	31	32	33	34	35	36							
13													

**NOTE: Not more than 4 corners, all in the same town and range, may be recorded on this certificate.**

A. Description of original monument and accessories and/or subsequent restoration:

Northwest corner of Section 4 or Northeast corner of Section 5,  
T 11 N; R 16 W, Dalton Township

Set post June 25, 1837 by GLO Surveyors

Pine 6" S 7° E 27 L  
B Oak 7" S 20° W 28 L

B. Description of corner evidence found and/or method applied in restoring or reestablishing corner:

Found 1/2" rod in 3/4" pipe in monument box, as per  
Muskegon County Road Commission witness book.

NE 18" Oak 57.72  
SE Power Pole 42.57  
SE Power Pole 44.20  
NW Tel. Pole 47.50


POSITION OF SAID  
MONUMENTED CORNER  
REVIEWED & RATIFIED  
BY MUSKEGON COUNTY  
PEER GROUP IN ACCORDANCE  
WITH P.A. 345, OF 1990

*svv May 2, 1994*

C. Description of monument for corner and accessories established to perpetuate locating the position of the corner:

Set 2 3/4" by 20" Cast Iron Monument  
with County Surveyor Cap in Monument Box.

S 52° W 44.20' Fd. nail North side power pole  
S 40° E 42.59' Fd. nail Southwest side power pole  
N 85° E 135.02' Set nail North side power pole  
S 75° E 143.89' Set nail South side power pole  
N 5° E 153.64' Set nail East side 20" oak  
N 40° W 46.66' Set nail Northeast side power pole

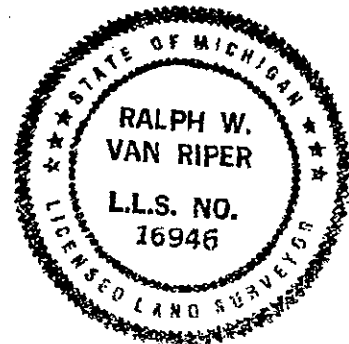

Signed by *Ralph W. Van Riper* Date 12/27/94  
Surveyor's Michigan License No. 16946