

L1871 Pg. 600

A1724

LAND CORNER RECORDATION CERTIFICATE
Filing Requirement of Act 74, Mich. P.A. 1970


STATE OF MICHIGAN
COUNTY OF MUSKEGON
REGISTER OF DEEDS
1995 DEC 10 PM 4:13
Coburn

For corners in
Muskegon
(County)

Located In: Corner Code #
T 11N R 16W E-2
T _____ R _____
T _____ R _____
T _____ R _____
T _____ R _____
SURVEY &
MONUMENTATION
APR 04 1996
COMMISSION

- 1. Public Land Survey
- 2. Property Controlling in Section
- 3. Miscellaneous Property in Sec.
- 4. Lot No. _____, Recorded Plat _____
- 5. Private Claims _____

Register of Deeds Stamp & File Number

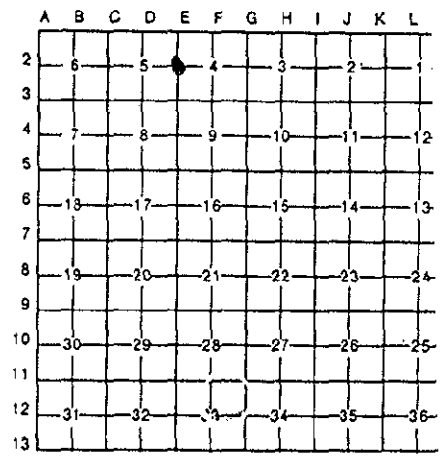

I, Stephen V. Vallier, P.S., in a field survey on October 25, 1995, do hereby certify that under requirements of P.A. 74, Michigan P.A. of 1970, the corner points mentioned in lines 1 and 2 above were in conformance with regulations and rules therefore as required in the current manual of survey instructions of the United States Department of the Interior, Bureau of Land Management or by a decree of a Court of Law and/or that the corner points mentioned in lines 3, 4 and 5 above were in conformance with the rules of the Michigan Board of Land Surveyors or by a Decree of a Court of Law; established, re-established, monumented, re-monumented, recovered, found as expressed below:

NOTE: Not more than 4 corners, all in the same town and range, may be recorded on this certificate.

A. Description of original monument and accessories and/or subsequent restoration:

- 1837 GLO set corner S 42 deg. W 19 Links 6" Black Oak
- S 74 deg. E 62 Links 12" Black Oak
- 1910 T. Norlin corner shown on Plat of Lakewood Village
- 1983 CF Lewandowski found 1/2" Iron Rod on top of 1" solid iron in Monument Box. Reset with 2 3/4" x 9" Cast Iron Monument with County Survey Cap recorded LCRC Liber 1268 Page 51
- N 65 deg. E 35.04' Power Pole (nail)
- N 40 deg. W 61.21' 14" Oak (nail)
- S 65 deg. W 56.36' 14" Oak (nail)
- S 45 deg. E 76.50' 14" Oak (nail)

B. Description of corner evidence found and/or method applied in restoring or reestablishing corner:


Found 2 3/4" x 9" Cast Iron Monument with County survey Cap in Monument Box. Position of corner agrees with recorded plat distance to section corners North and South.

POSITION OF SAID RECORDED CORNER REVIEWED & RATIFIED BY MUSKEGON COUNTY PEER GROUP IN ACCORDANCE WITH P.A. 345, OF 1990

Nov. 13, 1995

C. Description of monument for corner and accessories established to perpetuate locating the position of the corner:
Found 2 3/4" x 9" Cast Iron Monument with County Survey Cap in Monument Box.

- N 65 deg. E 35.04' Power Pole (nail)
- N 40 deg. W 61.21' 14" Oak (nail)
- S 65 deg. W 56.36' 14" Oak (nail)
- S 45 deg. E 76.50' 14" Oak (nail)

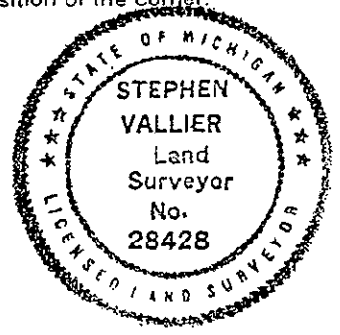

Signed by Stephen V. Vallier Date 12/15/95
Surveyor's Michigan License No. 28428