

LAND CORNER RECORDATION CERTIFICATE
Filing Requirement of Act 74, Mich. P.A. 1970

For corners in
Muskegon County

Located in: Corner Code #

- 1. Public Land Survey T 11N R 16W E-4
- 2. Property Controlling in Section S T R SURVEY & RE-MONUMENTATION
- 3. Miscellaneous Property in Sec. S T R APR 04 1996
- 4. Lot No. Recorded Plat COMMISSION
- 5. Private Claims


STATE OF MICHIGAN
COUNTY OF MUSKEGON
RECEIVED
1995 DEC 12 AM 11:4
Register of Deeds Stamp & File Number

A	B	C	D	E	F	G	H	I	J	K	L	M
2	6	5	4	3	2	1						
3												
4	7	8	9	10	11	12						
5												
6	18	17	16	15	14	13						
7												
8	19	20	21	22	23	24						
9												
10	30	29	28	27	26	25						
11												
12	31	32	33	34	35	36						
13												

I, Donald G. Sandel, in a field survey on Nov. 20, 1995 hereby certify that under requirements of P.A. 74, Michigan P.A. of 1970, the corner points mentioned in lines 1 and 2 above were in conformance with regulations and rules therefore as required in the current manual of survey instructions of the United States Department of the Interior, Bureau of Land Management or by a decree of a Court of Law and/or that the corner points mentioned in lines 3, 4 and 5 above were in conformance with the rules of the Michigan Board of Land Surveyors or by a Decree of a Court of Law; established, re-established, monumented, re-monumented, recovered, found as expressed below:

NOTE: Not more than 4 corners, all in the same town and range, may be recorded on this certificate.

- A. Description of original monument and accessories and/or subsequent restoration:
- (1) GLO: Set quarter section post, June 25, 1837.
Pine 40" N68°E, .44 Chains
Pine 20" N45°W, .44 Chains
 - (2) MCRC (1950's): 18" B. Oak NW 50.9', 8" W. Oak SE 43.1', 12" W. Oak WSW 40.85'
 - (3) Muskegon County Witness Book Witnesses: found Angle Iron in Monument Box - Sandel
N65°E, 8" Oak 51.00'
S86°E, 6" Pine, 39.95'
S60°W, 12" Oak, 41.42'

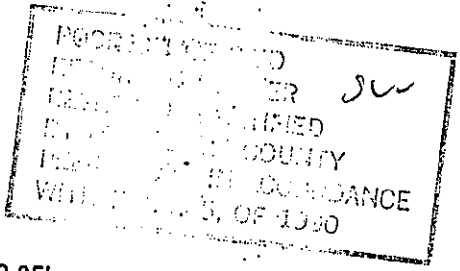


- Description of corner evidence found and/or method applied in restoring or reestablishing corner:
- (1) Found ±2' long angle iron inside monument box at ± center line Russell Road. Verified corner location with existing witnesses.
 - (2) Historical usage, documentation, and evidence of corner location reviewed and ratified by the Muskegon County Peer Group, March 7, 1995.

Description of monument for corner and accessories established to perpetuate locating the position of the corner:

Set 2 3/4" X 30" Cast Iron "County Survey" monument in place of found 3/4" & 1 1/2" pipe; witnessed as follows:

- N90°W, set nail N side, 20" Oak, 40.76'
- N55°W, set nail NE side, 22" Oak, 51.92'
- S65°W, set nail SE side, 20" Oak, 41.62'
- N47°E, set nail S side, 8" Oak, 59.23'
- N68°E, set nail S side, 12" Oak, 51.03'
- S57°E, found nail SW side, 12" Oak, 43.03'

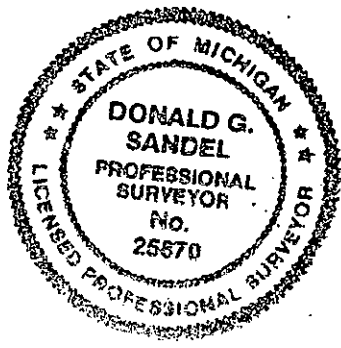

by Donald G. Sandel Date 5 December 1995
 Surveyor's Michigan License No. 25870