

R1871 Pg. 575

A1709

LAND CORNER RECORDATION CERTIFICATE
Filing Requirement of Act 74, Mich. P.A. 1970

For corners in

Muskegon
(County)

Located In:

Corner Code #

- 1. Public Land Survey T 11N R 16W E 9
T _____ R _____ SURVEY &
T _____ REMONUMENTATION
T _____ R _____
- 2. Property Controlling S _____ T _____ R _____
in Section S _____ T _____ R NOV 28 2000
- 3. Miscellaneous S _____ T _____ R _____
Property in Sec. S _____ T _____ R SECTION
- 4. Lot No. _____, Recorded Plat _____
- 5. Private Claims _____

STATE OF MICHIGAN
 COUNTY OF MUSKEGON
 REGISTER OF DEEDS
 1995 DEC 18 PM 4:10
 DEPARTMENT OF STATE
 LAND SURVEYORS

Register of Deeds Stamp & File Number

I, Stephen V. Vallier, P.S., in a field survey on November 15, 19 95, do hereby certify that under requirements of P.A. 74, Michigan P.A. of 1970, the corner points mentioned in lines 1 and 2 above were in conformance with regulations and rules therefore as required in the current manual of survey instructions of the United States Department of the Interior, Bureau of Land Management or by a decree of a Court of Law and/or that the corner points mentioned in lines 3, 4 and 5 above were in conformance with the rules of the Michigan Board of Land Surveyors or by a Decree of a Court of Law; established, re-established, monumented, re-monumented, recovered, found as expressed below:

NOTE: Not more than 4 corners, all in the same town and range, may be recorded on this certificate.

| | | | | | | | | | | | | | |
|----|----|---|----|---|----|---|----|---|----|---|----|---|---|
| | A | B | C | D | E | F | G | H | I | J | K | L | I |
| 2 | 6 | | 5 | | 4 | | 3 | | 2 | | 1 | | |
| 3 | | | | | | | | | | | | | |
| 4 | 7 | | 8 | | 9 | | 10 | | 11 | | 12 | | |
| 5 | | | | | | | | | | | | | |
| 6 | 18 | | 17 | | 16 | | 15 | | 14 | | 13 | | |
| 7 | | | | | | | | | | | | | |
| 8 | 19 | | 20 | | 21 | | 22 | | 23 | | 24 | | |
| 9 | | | | | | | | | | | | | |
| 10 | 30 | | 29 | | 28 | | 27 | | 26 | | 25 | | |
| 11 | | | | | | | | | | | | | |
| 12 | 31 | | 32 | | 33 | | 34 | | 35 | | 36 | | |
| 13 | | | | | | | | | | | | | |

A. Description of original monument and accessories and/or subsequent restoration:

- | | | | |
|----------------------------|-------------|-------------------------------------|---------------|
| 1837 GLO set corner | S 38 deg. E | 49 Links | 12" White Oak |
| | S 18 deg. W | 60 Links | 12" White Oak |
| 1928 County Survey Records | NE 96.60' | SW corner school step (bottom step) | |
| 1950 MCRC Iron | NE 96.60' | SW corner bottom step | |
| | SE 57.65' | 8" Locust | |
| | SW 71.76' | Power Pole | |
| | NW 77.33' | Telephone Pole | |

(see attached Exhibit "A")

B. Description of corner evidence found and/or method applied in restoring or reestablishing corner:

Found 1/2" x 18" Iron Rod in Monument Box - over a 1" x 24" bent pipe

N 55 deg. E 96.90' SW corner school step (bottom)

Accepted position of corner due to historical usage and documentation.


POSITION OF SAID
 RECORDED CORNER
 REVIEWED & RATIFIED
 BY MUSKEGON COUNTY
 PEER GROUP IN ACCORDANCE
 WITH P.A. 345, OF 1990

Aug. 1, 1995 SVV

C. Description of monument for corner and accessories established to perpetuate locating the position of the corner:

Set 2 3/4" x 30" Cast Iron Monument with County Survey Cap in Monument Box in place of found 1/2" Rod

- | | |
|--------------------|---------------------------------------|
| N 56 deg. E 56.47' | Telephone Pole (found nail) |
| N 55 deg. E 96.60' | SW corner bottom school step |
| S 35 deg. E 71.62' | Power Pole (found nail) |
| N 32 deg. W 48.24' | Found PK nail in W leg highway sign |
| S 22 deg. W 77.50' | 6" Wood Sign Post (set nail with tag) |
| S 22 deg. E 84.82' | 6" Wood sign Post (set nail with tag) |

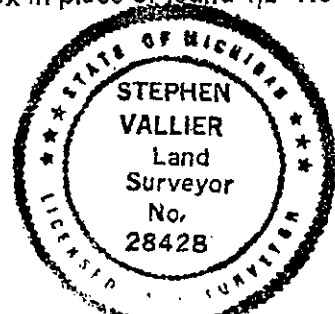

Signed by Stephen V. Vallier

Date 12/15/95

Surveyor's Michigan License No. 28428

A1709