

APR 04 1996

COMMISSION

LAND CORNER RECORDATION CERTIFICATE
Filing Requirement of Act 74, Mich. P.A. 1970

For corners in
Muskegon
(County)

Located In: Corner Code #

1. Public Land Survey	T	11N	R	16W	E 13
	T		R		
	T		R		
	T		R		
2. Property Controlling in Section	S		T	R	
	S		T	R	
3. Miscellaneous Property in Sec.	S		T	R	
	S		T	R	

Register of Deeds Stamp & File Number

4. Lot No. _____, Recorded Plat _____
5. Private Claims _____

I, Ralph W VanRiper, in a field survey on Dec. 5, 1995, do hereby certify that under requirements of P.A. 74, Michigan P.A. of 1970, the corner points mentioned in lines 1 and 2 above were in conformance with regulations and rules therefore as required in the current manual of survey instructions of the United States Department of the Interior, Bureau of Land Management or by a decree of a Court of Law and/or that the corner points mentioned in lines 3, 4 and 5 above were in conformance with the rules of the Michigan Board of Land Surveyors or by a Decree of a Court of Law; established, re-established, monumented, re-monumented, recovered, found as expressed below:

NOTE: Not more than 4 corners, all in the same town and range, may be recorded on this certificate.

A	B	C	D	E	F	G	H	I	J	K	L
2	6	5	4	3	2						
3											
4	7	8	9	10	11	12					
5											
6	18	17	16	15	14	13					
7											
8	19	20	21	22	23	24					
9											
10	30	29	28	27	26	25					
11											
12	31	32	33	34	35	36					
13											


A. Description of original monument and accessories and/or subsequent restoration:

Southeast corner of Section 32 or Southwest corner of Section 33, T 11 N, Range 16 W, Dalton Township. 10" Pine Tree at corner in 1837, GLO Surveyors

MCRC (1950's) 4 Witnesses to Corner
MCRC Witness Book, 1/2" Iron Stake with 6 Witnesses

B. Description of corner evidence found and/or method applied in restoring or reestablishing corner:

Found 1/2" Steel Road inside of 1 1/4" Iron Pipe in Asphalt Pavement-River Rd
Verified corner location with existing witnesses.

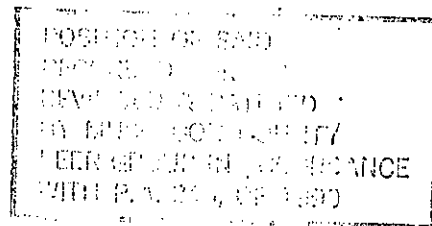

SW 12/4/95

C. Description of monument for corner and accessories established to perpetuate locating the position of the corner:

Set 2 3/4" Cast Iron Monument with County Survey Cap in Asphalt Pavement

- North 27.70' Set Spike in E side of 12" Pine
- N 25° E 36.67' Found Spike in N side of Twin 10" Oak
- N 58° E 66.71' Set Spike in SE side of Triple 10" Oak
- S 58° W 55.92' Set Spike in N side of 24" Oak
- S 70° W 67.24' Found Spike in NW side of Light Pole
- N 30° W 29.74' Center of Top Bolt of Fire Hydrant



Signed by Ralph W. VanRiper
Surveyor's Michigan License No. 16946

Date Dec. 19, 1995