

1995 DEC 28 AM 8:45

LAND CORNER RECORDATION CERTIFICATE  
Filing Requirement of Act 74, Mich. P.A. 1970

For corners in  
Muskegon  
(County)

Located In: Corner Code ==

- 1. Public Land Survey T 11N R 16W F 5  
T \_\_\_\_\_ R \_\_\_\_\_  
T \_\_\_\_\_ R \_\_\_\_\_ SURVEY &  
T \_\_\_\_\_ R \_\_\_\_\_ REMONUMENTATION
- 2. Property Controlling S \_\_\_\_\_ T \_\_\_\_\_ R \_\_\_\_\_  
in Section S \_\_\_\_\_ T \_\_\_\_\_ R \_\_\_\_\_
- 3. Miscellaneous S \_\_\_\_\_ T \_\_\_\_\_ R \_\_\_\_\_  
Property in Sec. S \_\_\_\_\_ T \_\_\_\_\_ R \_\_\_\_\_

101757

Register of Deeds Stamp & File Number

COMMISSION

- 4. Lot No. \_\_\_\_\_, Recorded Plat \_\_\_\_\_
- 5. Private Claims \_\_\_\_\_

I, Ralph W. VanRiper, in a field survey on May 9, 19 95, do hereby certify that under requirements of P.A. 74, Michigan P.A. of 1970, the corner points mentioned in lines 1 and 2 above were in conformance with regulations and rules therefore as required in the current manual of survey instructions of the United States Department of the Interior, Bureau of Land Management or by a decree of a Court of Law and/or that the corner points mentioned in lines 3, 4 and 5 above were in conformance with the rules of the Michigan Board of Land Surveyors or by a Decree of a Court of Law; established, re-established, monumented, re-monumented, recovered, found as expressed below:

NOTE: Not more than 4 corners, all in the same town and range, may be recorded on this certificate.

A. Description of original monument and accessories and/or subsequent restoration:


1/4 Corner common to Sections 9 and 16, T 11 N, R 16 W, Dalton Township

Post set by GLO Surveyors in 1837 (B Oak 8", S 17° E, 25L) (B Oak 20", N 4° W, 44L)

MCRC (1950's) 3 Witnesses  
MCRC Witness Book Same 3 Witnesses

B. Description of corner evidence found and/or method applied in restoring or reestablishing corner:

Found Axle Shaft in Sand Road - Michillinda Road  
Verified corner location with existing witnesses

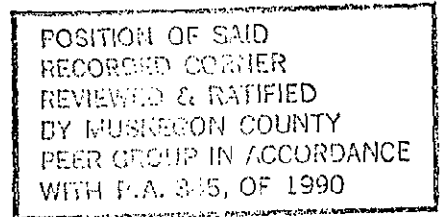

4/4/95 sm

C. Description of monument for corner and accessories established to perpetuate locating the position of the corner:

Set 2 3/4" Cast Iron Monument with County Survey Cap

- N 15° W 20.25' Set Spike in W side of 10" Oak
- East 10.50' Found Spike in 12" Oak stump
- S 4° W 33.06' Found Concrete Mounment
- S 50° W 42.06' Set Spike in SE side of 12" Oak
- West 35.45' Set Spike in S side of 14" Oak
- N 51° W 46.68' Found Spike in SW side of 12" Oak



igned by Ralph W. Van Riper Date Dec. 19, 1995  
urveyor's Michigan License No. 16946