

1993

COMMISSION

LAND CORNER RECORDATION CERTIFICATE
Filing Requirement of Act 74, Mich. P.A. 1970

STATE OF MICHIGAN
COUNTY OF MUSKEGON
REGISTER OF DEEDS
RECEIVED FOR RECORD
1993 DEC 29 PM 3:07
Carrie Carter

For corners in

<u>Muskegon</u> <small>(County)</small>	Located In:	Corner Code //
1. Public Land Survey	T <u>11N</u> R <u>16W</u>	<u>F 7</u>
	T _____ R _____	_____
	T _____ R _____	_____
	T _____ R _____	_____
2. Property Controlling in Section	S _____ T _____ R _____	_____
3. Miscellaneous Property in Sec.	S _____ T _____ R _____	_____
4. Lot No. _____, Recorded Plat _____		
5. Private Claims _____		

Register of Deeds Stamp & File Number

I, Ralph W. VanRiper, in a field survey on May 27, 19 93, do hereby certify that under requirements of P.A. 74, Michigan P.A. of 1970, the corner points mentioned in lines 1 and 2 above were in conformance with regulations and rules therefore as required in the current manual of survey instructions of the United States Department of the Interior, Bureau of Land Management or by a decree of a Court of Law and/or that the corner points mentioned in lines 3, 4 and 5 above were in conformance with the rules of the Michigan Board of Land Surveyors or by a Decree of a Court of Law; established, re-established, monumented, re-monumented, recovered, found as expressed below:

	A	B	C	D	E	F	G	H	I	J	K	L	M
2	6	5	4	3	2	1							
3													
4	7	8	9	10	11	12							
5													
6	18	17	16	15	14	13							
7													
8	19	20	21	22	23	24							
9													
10	30	29	28	27	26	25							
11													
12	31	32	33	34	35	36							
13													

NOTE: Not more than 4 corners, all in the same town and range, may be recorded on this certificate.

A. Description of original monument and accessories and/or subsequent restoration:

1/4 Corner between Sections 16 and 21, T 11 N, R 16 W, Dalton Township

Post set June 24, 1837 by GLO Surveyors

W Oak 20" S 59° E 26 L
W Oak 16" S 75° W 41 L

B. Description of corner evidence found and/or method applied in restoring or reestablishing corner:


Found 1/2" Steel Rod over 1/2" Steel Pipe	Face, Steel Cor. Post	NE	41.25'
Recorded by Donald Schiele, RLS No. 23517	Tel. Pole	SW	52.04'
Liber 1230, Page 472 - Jan. 5, 1982	33" Oak	SW	39.40'
	30" Oak	NW	45.10'

Historical usage, documentation and evidence of corner location reviewed and ratified by Muskegon County Peer Group, May 18, 1993

C. Description of monument for corner and accessories established to perpetuate locating the position of the corner:

Set 2 3/4" by 20" Cast Iron Monument with County Survey Cap

N 30° E 86.65'	Set Spike in 12" Pine
N 45° E 75.93'	Set Spike in 20" Pine
S 60° E 65.59'	Set Spike in 20" Maple
S 47° W 39.36'	Fd. Spike in 36" Oak
S 75° W 64.00'	Set Spike in 16" Oak
N 40° W 44.46'	Set Spike in 32" Oak

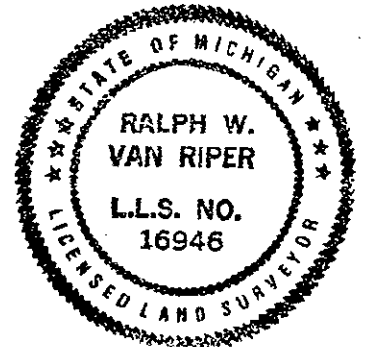

Signed by Ralph W. Van Riper

Date Dec. 28, 1993

Surveyor's Michigan License No. 16946