

COMMISSION

LAND CORNER RECORDATION CERTIFICATE  
Filing Requirement of Act 74, Mich. P.A. 1970

For corners in

Muskegon

(County)

Located In:

Corner Code #

- 1. Public Land Survey      T 11N R 16W      F 10
- T     R
- T     R
- T     R
- 2. Property Controlling    S     T     R
- in Section                S     T     R
- 3. Miscellaneous          S     T     R
- Property in Sec.        S     T     R

*Carlin Carter*  
REGISTER OF DEEDS

STATE OF MICHIGAN  
COUNTY OF MUSKEGON  
RECEIVED FOR RECORD  
1993 DEC 29 PM 3:08

Register of Deeds Stamp & File Number

- 4. Lot No. \_\_\_\_\_, Recorded Plat \_\_\_\_\_
- 5. Private Claims \_\_\_\_\_

I, Ralph W. VanRiper, in a field survey on Dec. 28, 19 93, do hereby certify that under requirements of P.A. 74, Michigan P.A. of 1970, the corner points mentioned in lines 1 and 2 above were in conformance with regulations and rules therefore as required in the current manual of survey instructions of the United States Department of the Interior, Bureau of Land Management or by a decree of a Court of Law and/or that the corner points mentioned in lines 3, 4 and 5 above were in conformance with the rules of the Michigan Board of Land Surveyors or by a Decree of a Court of Law; established, re-established, monumented, re-monumented, recovered, found as expressed below:

NOTE: Not more than 4 corners, all in the same town and range, may be recorded on this certificate.

	A	B	C	D	E	F	G	H	I	J	K	L	M
2	6		5		4		3		2				
3													
4	7		8		9		10		11		12		
5													
6	18		17		16		15		14		13		
7													
8	19		20		21		22		23		24		
9													
10	30		29		28		27		26		25		
11													
12	31		32		33		34		35		36		
13													

A. Description of original monument and accessories and/or subsequent restoration:

Center of Section 28, T 11 N, R 16 W, Dalton Township

Not set by GLO Surveyors

B. Description of corner evidence found and/or method applied in restoring or reestablishing corner:

Found 1/2" Steel Rod, in Asphalt  
Shoulder of Highway US-31


All Witness from Muskegon County  
Road Commission Witness Book now  
removed by Highway US-31

Historical usage, documentation and evidence of corner location  
reviewed and ratified by Muskegon County Peer Group, Nov. 16, 1993

C. Description of monument for corner and accessories established to perpetuate locating the position of the corner:

Set 2 3/4" by 20" Cast Iron Monument with County Survey Cap

- N 6° E 66.95' Set "PK" Nail in Guard Rail Post
- N 69° E 48.26' Set "PK" Nail in Guard Rail Post
- S 54° E 176.32' Set "X" in Conc. Bridge Railing
- S 40° E 175.24' Set "X" in Conc. Bridge Railing
- N 51° W 49.96' Set "PK" Nail in Guard Rail Post
- S 41° W 6.19' Set "PK" Nail in Guard Rail Post

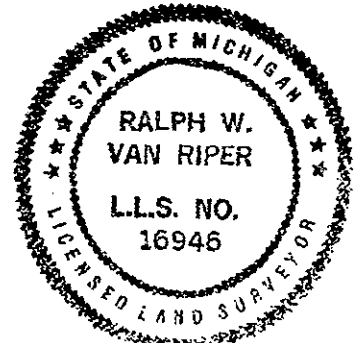

Signed by Ralph W. VanRiper

Date Dec. 28, 1993

Surveyor's Michigan License No. 16946