

L1871 601

A1725

LAND CORNER RECORDATION CERTIFICATE
Filing Requirement of Act 74, Mich. P.A. 1970

For corners in
Muskegon
(County)

Located In: Corner Code #

- 1. Public Land Survey T 11N R 16W F-11
- T _____ R _____
- T _____ R _____
- T _____ R _____
- 2. Property Controlling S _____ T _____ R _____
- in Section S _____ T _____ R _____
- 3. Miscellaneous S _____ T _____ R _____
- Property in Sec. S _____ T _____ R _____


SURVEY & MONUMENTATION

APR 04 1996

STATE OF MICHIGAN
COUNTY OF MUSKEGON
RECEIVED
1995 DEC 18 9M 4P 14

Register of Deeds Stamp & File Number

- 4. Lot No. _____, Recorded Plat COMMISSION
- 5. Private Claims _____

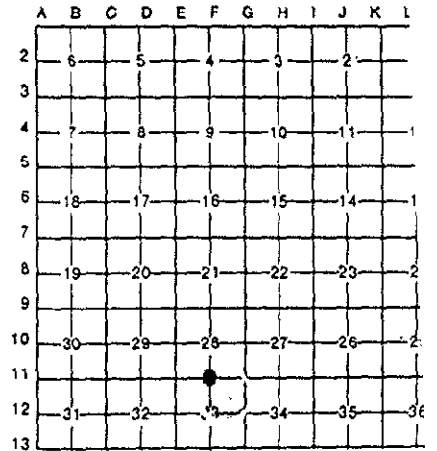

I, Stephen V. Vallier, P.S. in a field survey on October 25, 1995, do hereby certify that under requirements of P.A. 74, Michigan P.A. of 1970, the corner points mentioned in lines 1 and 2 above were in conformance with regulations and rules therefore as required in the current manual of survey instructions of the United States Department of the Interior, Bureau of Land Management or by a decree of a Court of Law and/or that the corner points mentioned in lines 3, 4 and 5 above were in conformance with the rules of the Michigan Board of Land Surveyors or by a Decree of a Court of Law; established, re-established, monumented, re-monumented, recovered, found as expressed below:

NOTE: Not more than 4 corners, all in the same town and range, may be recorded on this certificate.

- A. Description of original monument and accessories and/or subsequent restoration:
 - 1837 GLO corner set N 79 deg. W 19 Links 15" Pine
 - N 88 deg. E 29 Links 12" White Oak
 - 1950's MCRC - iron NE 60.30' 20" Oak
 - NW 61.57' 26" Oak
 - 1988 R. VanRiper found 1/2" Iron x 1 1/2" Iron Bar. Reset 4" x 30" Cast Iron Monument with County Survey Cap. Recorded LCRC Liber 1458 Page 297.
 - N 30 deg. E 60.30' 24" Oak (nail)
 - S 58 deg. E 55.75' 10" Oak (nail)
 - S 45 deg. W 61.79' 12" Ash (nail)
 - N 36 deg. W 61.57' 26" Oak (nail)

B. Description of corner evidence found and/or method applied in restoring or reestablishing corner:

Found 4" x 30" Cast Iron Monument with County Survey Cap. Witnesses check LCRC Liber 1458 Page 297. Corner is set Midway and on line of section corners.

POSITION OF SAID
RECORDED CORNER
REVIEWED & RATIFIED
BY MUSKEGON COUNTY
PEER GROUP IN ACCORDANCE
WITH P.A. 345, OF 1990

9/17/95

C. Description of monument for corner and accessories established to perpetuate locating the position of the corner:
Found 4" x 30" Cast Iron Monument with County Survey Cap.

- N 30 deg. E 60.30' 24" Oak (nail)
- S 58 deg. E 55.75' 10" Oak (nail)
- S 45 deg. W 61.79' 12" Ash (nail)
- N 36 deg. W 61.57' 26" Oak (nail)



Signed by Stephen V. Vallier
Surveyor's Michigan License No. 28428

Date 12/15/95