

1993

COMMISSION

LAND CORNER RECORDATION CERTIFICATE  
Filing Requirement of Act 74, Mich. P.A. 1970

STATE OF MICHIGAN  
COUNTY OF MUSKEGON  
RECEIVED FOR RECORD  
1993 DEC 29 PM 3:08  
C. Van Riper  
REGISTER OF DEEDS

For corners in

<u>Muskegon</u> (County)	Located In:	Corner Code #
1. Public Land Survey	T <u>11N</u> R <u>16W</u>	F 12
	T _____ R _____	_____
	T _____ R _____	_____
	T _____ R _____	_____
2. Property Controlling in Section	S _____ T _____ R _____	_____
	S _____ T _____ R _____	_____
3. Miscellaneous Property in Sec.	S _____ T _____ R _____	_____
	S _____ T _____ R _____	_____

Register of Deeds Stamp & File Number

- 4. Lot No. \_\_\_\_\_, Recorded Plat \_\_\_\_\_
- 5. Private Claims \_\_\_\_\_

A	B	C	D	E	F	G	H	I	J	K	L	M
2	6	5	4	3	2	1						
3												
4	7	8	9	10	11	12						
5												
6	13	17	16	15	14	13						
7												
8	19	20	21	22	23	24						
9												
10	30	29	28	27	26	25						
11												
12	31	32	33	34	35	36						
13												

I, Ralph W. VanRiper, in a field survey on Nov. 22, 1993, do hereby certify that under requirements of P.A. 74, Michigan P.A. of 1970, the corner points mentioned in lines 1 and 2 above were in conformance with regulations and rules therefore as required in the current manual of survey instructions of the United States Department of the Interior, Bureau of Land Management or by a decree of a Court of Law and/or that the corner points mentioned in lines 3, 4 and 5 above were in conformance with the rules of the Michigan Board of Land Surveyors or by a Decree of a Court of Law; established, re-established, monumented, re-monumented, recovered, found as expressed below:

NOTE: Not more than 4 corners, all in the same town and range, may be recorded on this certificate.

A. Description of original monument and accessories and/or subsequent restoration:

Center of Section 33, T 11 N, R 16 W, Dalton Township  
Not set by GLO Surveyors


B. Description of corner evidence found and/or method applied in restoring or reestablishing corner:

Found Caped 1/2" Steel Rod by Donald G. Sandel, RLS No. 25870	Muskegon County Road Comm. Witness Book
Historical usage, documentation and evidence of corner location reviewed and ratified by Muskegon County Peer Group, Nov. 16, 1993	N 65° W 65.2' 16" Oak S 55° W 59.0' 30" Stump W 33.0' 1/2" Rod E 32.88' 1/2" Rod SW 60.0' W. Oak SE 40' 16" W. Oak

C. Description of monument for corner and accessories established to perpetuate locating the position of the corner:

Set 2 3/4" by 20" Cast Iron Monument with County Survey Cap

S 69° E 70.48' Set Spike in 20" Oak  
 S 49° E 72.00' Set Spike in 16" Oak  
 S 25° E 63.98' Set Spike in Tw. 12" Oak  
 S 51° W 59.00' Fd. Spike in 20" Stump  
 N 62° W 65.32' Fd. Spike in 20" Oak  
 N 52° W 47.45' Fd. Spike in 20" Oak

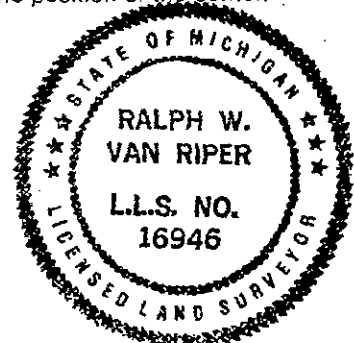

Signed by Ralph W. Van Riper Date Dec. 28, 1993  
Surveyor's Michigan License No. 16946