

1833

COMMISSION

LAND CORNER RECORDATION CERTIFICATE
Filing Requirement of Act 74, Mich. P.A. 1970

For corners in

Muskegon
(County)

Located In:

Corner Code: H

- | | | | | | |
|------------------------------------|---|------------|---|------------|-------------|
| 1. Public Land Survey | T | <u>11N</u> | R | <u>16W</u> | <u>F 13</u> |
| | T | _____ | R | _____ | _____ |
| | T | _____ | R | _____ | _____ |
| | T | _____ | R | _____ | _____ |
| 2. Property Controlling in Section | S | T | R | | |
| | S | T | R | | |
| 3. Miscellaneous Property in Sec. | S | T | R | | |
| | S | T | R | | |

1993 DEC 29 PM 3:09
 REGISTER OF DEEDS
 STATE OF MICHIGAN
 COUNTY OF MUSKEGON
 RECORDATION RECORD

Register of Deeds Stamp & File Number

4. Lot No. _____, Recorded Plat _____
5. Private Claims _____

A	B	C	D	E	F	G	H	I	J	K	L	M
2	6	5	4	3	2	1						
3												
4	7	8	9	10	11	12						
5												
6	18	17	16	15	14	13						
7												
8	19	20	21	22	23	24						
9												
10	30	29	28	27	26	25						
11												
12	31	32	33	34	35	36						
13												

I, Ralph W. VanRiper, in a field survey on Nov. 22, 19 93, do hereby certify that under requirements of P.A. 74, Michigan P.A. of 1970, the corner points mentioned in lines 1 and 2 above were in conformance with regulations and rules therefore as required in the current manual of survey instructions of the United States Department of the Interior, Bureau of Land Management or by a decree of a Court of Law and/or that the corner points mentioned in lines 3, 4 and 5 above were in conformance with the rules of the Michigan Board of Land Surveyors or by a Decree of a Court of Law; established, re-established, monumented, re-monumented, recovered, found as expressed below:

NOTE: Not more than 4 corners, all in the same town and range, may be recorded on this certificate.

A. Description of original monument and accessories and/or subsequent restoration:

South 1/4 Corner of Section 33, T 11 N, R 16 W, Dalton Township

Set Post in 1836 by GLO Surveyors

W Oak 10" N 61° E 45 L
 Y Oak 10" N 18° W 54 L


B. Description of corner evidence found and/or method applied in restoring or reestablishing corner:

Found 1/2" Steel Road as per Muskegon County Road Commission Witness Book	N 43° E 55.96'	Tw. Oak
Historical usage, documentation and evidence of corner location reviewed and ratified by Muskegon County Peer Group, Nov. 16, 1993	S 45° W 36.43'	P & T Pole
	S 47.47'	14" Pine
	SW 66.05'	12" Stump
	SE 46.18'	18" Stump

C. Description of monument for corner and accessories established to perpetuate locating the position of the corner:

Set 2 3/4" by 20" Cast Iron Monument with County Survey Cap

N 43° E 55.96' Fd. Spike in Tw. 16" Oak
 N 46° E 49.40' Center of Fire Hydrant Bolt
 S 29° E 48.55' Fd. Spike in 6" Oak
 S 44° W 49.52' Fd. Spike in 12" Oak
 S 62° W 84.56' Fd. Spike in Tw. 15" Oak
 N 43° W 36.68' Fd. Spike in Power Pole

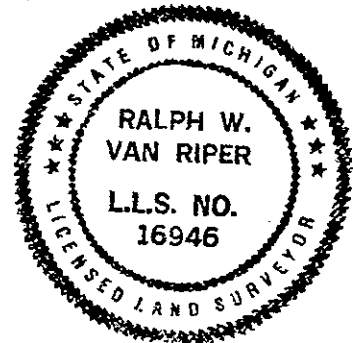

Signed by Ralph W. Van Riper Date Dec. 28, 1993

Surveyor's Michigan License No. 16946