

**SURVEY &
REMONUMENTATION**

LIBER **1810** PAGE **625**

STATE OF MICHIGAN
COUNTY OF MUSKEGON
RECEIVED FOR RECORD

APR 28 1995

1994 DEC 29 AM 10:18

COMMISSION

LAND CORNER RECORDATION CERTIFICATE
Filing Requirement of Act 74, Mich. P.A. 1970

Carrie Carter
REGISTER OF DEEDS

For corners in

<u>Muskegon</u> (County)	Located In:	Corner Code #
1. Public Land Survey	T <u>11N</u> R <u>16W</u>	<u>G 2</u>
	T _____ R _____	_____
	T _____ R _____	_____
	T _____ R _____	_____
2. Property Controlling in Section	S _____ T _____ R _____	_____
	S _____ T _____ R _____	_____
3. Miscellaneous Property in Sec.	S _____ T _____ R _____	_____
	S _____ T _____ R _____	_____
4. Lot No. _____, Recorded Plat _____		
5. Private Claims _____		

A1649

Register of Deeds Stamp & File Number

A	B	C	D	E	F	G	H	I	J	K	L	M
2	6	5	4	3	2	1						
3												
4	7	8	9	10	11	12						
5												
6	18	17	16	15	14	13						
7												
8	19	20	21	22	23	24						
9												
10	30	29	28	27	26	25						
11												
12	31	32	33	34	35	36						
13												

I, Ralph W. VanRiper, in a field survey on September 16, 1994, do hereby certify that under requirements of P.A. 74, Michigan P.A. of 1970, the corner points mentioned in lines 1 and 2 above were in conformance with regulations and rules therefore as required in the current manual of survey instructions of the United States Department of the Interior, Bureau of Land Management or by a decree of a Court of Law and/or that the corner points mentioned in lines 3, 4 and 5 above were in conformance with the rules of the Michigan Board of Land Surveyors or by a Decree of a Court of Law; established, re-established, monumented, re-monumented, recovered, found as expressed below:

NOTE: Not more than 4 corners, all in the same town and range, may be recorded on this certificate.

A. Description of original monument and accessories and/or subsequent restoration:

1/4 corner between Sections 3 and 4, T 11 N, R 16 W, Dalton Township.

Set post June 24, 1837, by GLO Surveyors

20" Pine S 36° W 16 L
18" Pine N 48° W 13 L

B. Description of corner evidence found and/or method applied in restoring or reestablishing corner:

Found axel shaft per Muskegon County Road Commission Witness book.

SE 8" Oak 10.85'
NE 10" Oak 16.77'
NW 4" Oak 18.85'
SW 14" Oak 30.50'


POSITION OF SAID
RECORDED CORNER
REVIEWED & RATIFIED
BY MUSKEGON COUNTY
PEER GROUP IN ACCORDANCE
WITH P.A. 345, OF 1990

May 2, 1994

C. Description of monument for corner and accessories established to perpetuate locating the position of the corner:

Set 4" by 30" Cast Iron Monument with County Surveyor Cap

S 70° E 10.85' Fd. spike North side 8" Oak
N 45° E 16.72' Fd. spike Northwest side 10" Oak
N 20° W 18.85' Fd. spike West side 4" Oak
S 70° W 30.49' Fd. spike North side 14" Oak
N 45° W 37.96' Set spike Southwest side 10" Oak
N 20° E 53.83' Set spike West side 10" Oak

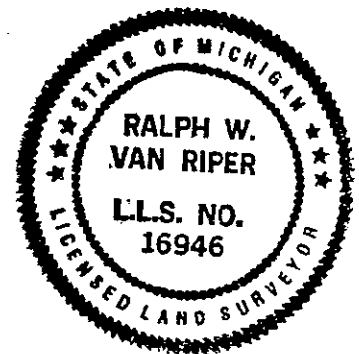

Signed by *Ralph W. Van Riper*
Surveyor's Michigan License No. 16946

Date 12/27/94