

COMMISSION

LAND CORNER RECORDATION CERTIFICATE
Filing Requirement of Act 74, Mich. P.A. 1970

For corners in
Muskegon
(County)

Located In: Corner Code #

1. Public Land Survey	T	<u>11N</u>	R	<u>16W</u>	<u>G 7</u>
	T		R		
	T		R		
	T		R		
2. Property Controlling in Section	S		T	R	
	S		T	R	
3. Miscellaneous Property in Sec.	S		T	R	
	S		T	R	

REGISTER OF DEEDS
 1993 DEC 29 PM 3:07
 STATE OF MICHIGAN
 COUNTY OF MUSKEGON
 RECEIVED IN RECORD

Register of Deeds Stamp & File Number

- 4. Lot No. _____, Recorded Plat _____
- 5. Private Claims _____

A	B	C	D	E	F	G	H	I	J	K	L	M
2	6	5	4	3	2	1						
3												
4	7	8	9	10	11	12						
5												
6	18	17	16	15	14	13						
7												
8	19	20	21	22	23	24						
9												
10	30	29	28	27	26	25						
11												
12	31	32	33	34	35	36						

I, Ralph W. VanRiper, in a field survey on May 27, 1993, do hereby certify that under requirements of P.A. 74, Michigan P.A. of 1970, the corner points mentioned in lines 1 and 2 above were in conformance with regulations and rules therefore as required in the current manual of survey instructions of the United States Department of the Interior, Bureau of Land Management or by a decree of a Court of Law and/or that the corner points mentioned in lines 3, 4 and 5 above were in conformance with the rules of the Michigan Board of Land Surveyors or by a Decree of a Court of Law; established, re-established, monumented, re-monumented, recovered, found as expressed below:

NOTE: Not more than 4 corners, all in the same town and range, may be recorded on this certificate.

A. Description of original monument and accessories and/or subsequent restoration:

Section Corner common to Sections 15, 16, 21 and 22, T 11 N, R 16 W, Dalton Township
 Post Set June 23, 1837 by GLO Surveyors
 W Ash 12" at Corner

B. Description of corner evidence found and/or method applied in restoring or reestablishing corner:


Found 1 1/2" Pipe in Monument Box	"X" on Curb	NE	32.90'
Recorded by Donald W. Schiele, RLS No. 23516	"X" on Curb	SE	34.42'
Liber 1230, Page 472 - Jan 5, 1982	Cor. Fc. Post	SW	43.19'
	Power Pole	SW	70.52'
	Cor. Fc. Post	NW	56.35'

Historical usage, documentation and evidence of corner location reviewed and ratified by Muskegon County Peer Group, May 18, 1993

C. Description of monument for corner and accessories established to perpetuate locating the position of the corner:

Set 2 3/4 by 20" Cast Iron Monument with County Survey Cap in Moutment Box

N 47° E 45.64' Set "X" Cut in Conc. Curb
 S 60° E 40.69' Set "X" Cut in Conc. Curb
 S 42° E 139.58' NW cor. Brick Hse. No. 4580
 S 20° W 40.66' Set "X" Cur in Conc. Curb
 S 44° W 70.44' Fd. "PK" Nail in Power Pole
 N 58° W 41.40' Set "X" Cut in Conc. Curb

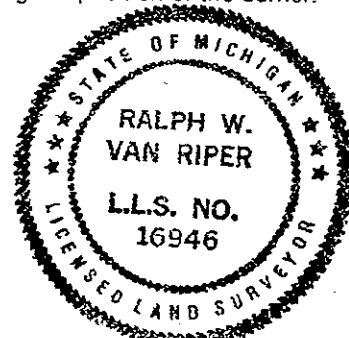

Signed by Ralph W. Van Riper

Date Dec. 28, 1993

Surveyor's Michigan License No. 16946