

COMMISSION

LAND CORNER RECORDATION CERTIFICATE
Filing Requirement of Act 74, Mich. P.A. 1970

For corners in

Muskegon Located In: Corner Code: //
(County)

1. Public Land Survey T 11N R 16W G 12
T _____ R _____
T _____ R _____
T _____ R _____

2. Property Controlling S T R
in Section S _____ T _____ R _____

3. Miscellaneous S T R
Property in Sec. S _____ T _____ R _____

STATE OF MICHIGAN
COUNTY OF MUSKEGON
REGISTER OF DEEDS
1993 DEC 29 PM 3:08
Carrie Carter

Register of Deeds Stamp & File Number

4. Lot No. _____, Recorded Plat _____
5. Private Claims _____

	A	B	C	D	E	F	G	H	I	J	K	L	M
2	6	5	4	3	2	1							
3													
4	7	8	9	10	11	12							
5													
6	18	17	16	15	14	13							
7													
8	19	20	21	22	23	24							
9													
10	30	29	28	27	26	25							
11													
12	31	32	33	34	35	36							
13													

I, Ralph W. VanRiper, in a field survey on June 8, 19 93, do hereby certify that under requirements of P.A. 74, Michigan P.A. of 1970, the corner points mentioned in lines 1 and 2 above were in conformance with regulations and rules therefore as required in the current manual of survey instructions of the United States Department of the Interior, Bureau of Land Management or by a decree of a Court of Law and/or that the corner points mentioned in lines 3, 4 and 5 above were in conformance with the rules of the Michigan Board of Land Surveyors or by a Decree of a Court of Law, established, re-established, monumented, re-monumented, recovered, found as expressed below:

NOTE: Not more than 4 corners, all in the same town and range, may be recorded on this certificate.

A. Description of original monument and accessories and/or subsequent restoration:

1/4 Corner between Sections 33 and 34, T 11 N, R 16 W, Dalton Township
Set Post June 23, 1837 by GLO Surveyors
Pine 18" S 81° W 16 L
Pine 22" N 68° E 93 L


B. Description of corner evidence found and/or method applied in restoring or reestablishing corner:

Found 1" Pipe over Square Bolt in Monument Box S 68° W 25.40' 20" Oak
Recorded by Charles F. Lewandoski, RLS No. 7867 N 88° W 61.30' P. Pole
Liber 1174, Page 736, July 30, 1979 S 25° E 65.70' 16" Oak
S 32° W 56.40' 24" Oak

Historical usage, documentation and evidence of corner location reviewed and ratified by Muskegon County Peer Group, June 15, 1993

C. Description of monument for corner and accessories established to perpetuate locating the position of the corner:

Set 2 3/4" by 20" Cast Iron Monument with County Survey Cap in Monument Box
S 22° E 65.70' Fd. Spike in 18" Oak
S 35° W 56.40' Fd. Spike in 24" Oak
S 50° W 35.12' Set Spike in 18" Oak
S 72° W 25.36' Fd. Spike in 22" Oak
N 83° W 61.26' Fd. Spike in Power Pole
N 75° W 28.22' Set Spike in 14" Oak

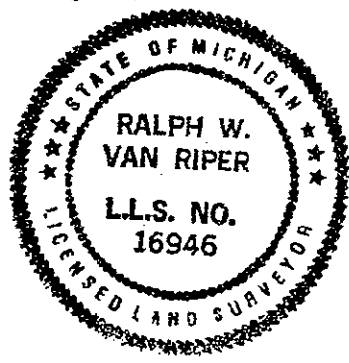

Signed by Ralph W. Van Riper Date Dec. 28, 1993
Surveyor's Michigan License No. 16946