

**SURVEY &
REMONUMENTATION**

LIBER **1810** PAGE **631**

APR 28 1995

STATE OF MICHIGAN
COUNTY OF MUSKEGON
RECEIVED FOR RECORD

1994 DEC 29 AM 10:18

COMMISSION

LAND CORNER RECORDATION CERTIFICATE
Filing Requirement of Act 74, Mich. P.A. 1970

Carrie Carter
REGISTER OF DEEDS

For corners in


Muskegon <small>(County)</small>	Located In:	Corner Code #
1. Public Land Survey	T <u>11N</u> R <u>16W</u>	<u>H 2</u>
	T _____ R _____	_____
	T _____ R _____	_____
	T _____ R _____	_____
2. Property Controlling in Section	S _____ T _____ R _____	_____
	S _____ T _____ R _____	_____
3. Miscellaneous Property in Sec.	S _____ T _____ R _____	_____
	S _____ T _____ R _____	_____

A1655

Register of Deeds Stamp & File Number

4. Lot No. _____, Recorded Plat _____
5. Private Claims _____

I, Ralph W. VanRiper, in a field survey on December 7, 19 94, do hereby certify that under requirements of P.A. 74, Michigan P.A. of 1970, the corner points mentioned in lines 1 and 2 above were in conformance with regulations and rules therefore as required in the current manual of survey instructions of the United States Department of the Interior, Bureau of Land Management or by a decree of a Court of Law and/or that the corner points mentioned in lines 3, 4 and 5 above were in conformance with the rules of the Michigan Board of Land Surveyors or by a Decree of a Court of Law, established, re-established, monumented, re-monumented, recovered, found as expressed below:

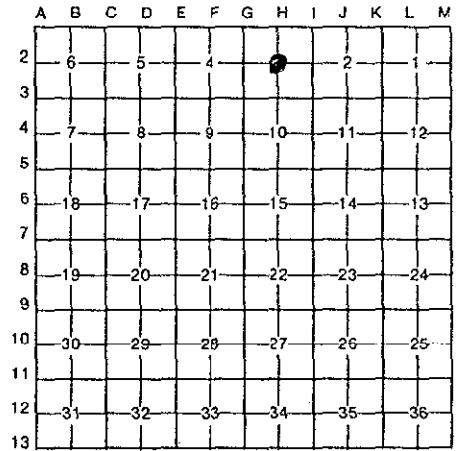

NOTE: Not more than 4 corners, all in the same town and range, may be recorded on this certificate.

A. Description of original monument and accessories and/or subsequent restoration:

Center of Section 3, T 11 N, R 16 W, Dalton Township,
Not set by GLO Surveyors.

B. Description of corner evidence found and/or method applied in restoring or reestablishing corner:

Found 1" pipe as per Muskegon County Road Commission
Witness book.

- SE 41.30' 14" Oak
- SW 45.05' 10" Pine
- NW 31.80' 6" Pine
- NE 10.87' 14" Oak Stump
- NW 15.88' 14" Oak Stump
- SSW 15.47' 12" Oak Stump

POSITION OF SAID
RECORDED CORNER
REVIEWED & LIMITED
BY MUSKEGON COUNTY
PEER GROUP IN ACCORDANCE
WITH P.A. 345, OF 1990

May 2, 1994 sw

C. Description of monument for corner and accessories established to perpetuate locating the position of the corner:

Set 2 3/4" by 20" Cast Iron Monument with
County Surveyor Cap.

- N 45° W 31.81' Fd. nail Southwest side 10" Pine.
- North 25.42' Set nail East side Twin Oak.
- N 80° W 13.41' Set nail Northeast side 8" Oak.
- S 30° W 11.09' Set nail East side 8" Oak.
- S 15° E 21.02' Set nail East side 6" Oak.
- N 80° E 10.95' Fd. nail Northwest side 14" stump.



Signed by *Ralph W. Van Riper*
Surveyor's Michigan License No. 16946

Date 12/27/94