

**SURVEY &
REMONUMENTATION**

LIBER **1810** PAGE **632**

APR 28 1995

STATE OF MICHIGAN
COUNTY OF MUSKEGON
RECEIVED FOR RECORD

LAND CORNER RECORDATION CERTIFICATE
Filing Requirement of Act 74, Mich. P.A. 1970

1994 DEC 29 AM 10:19

COMMISSION

For corners in

<u>Muskegon</u> (County)	Located In:	Corner Code #
1. Public Land Survey	T <u>11N</u> R <u>16W</u>	<u>H 3</u>
	T _____ R _____	_____
	T _____ R _____	_____
	T _____ R _____	_____
2. Property Controlling in Section	S _____ T _____ R _____	_____
	S _____ T _____ R _____	_____
3. Miscellaneous Property in Sec.	S _____ T _____ R _____	_____
	S _____ T _____ R _____	_____


Carrie Carter
REGISTER OF DEEDS

A1656

Register of Deeds Stamp & File Number

4. Lot No. _____, Recorded Plat _____
5. Private Claims _____

I, Ralph W. VanRiper, in a field survey on November 3, 19 94, do hereby certify that under requirements of P.A. 74, Michigan P.A. of 1970, the corner points mentioned in lines 1 and 2 above were in conformance with regulations and rules therefore as required in the current manual of survey instructions of the United States Department of the Interior, Bureau of Land Management or by a decree of a Court of Law and/or that the corner points mentioned in lines 3, 4 and 5 above were in conformance with the rules of the Michigan Board of Land Surveyors or by a Decree of a Court of Law; established, re-established, monumented, re-monumented, recovered, found as expressed below:

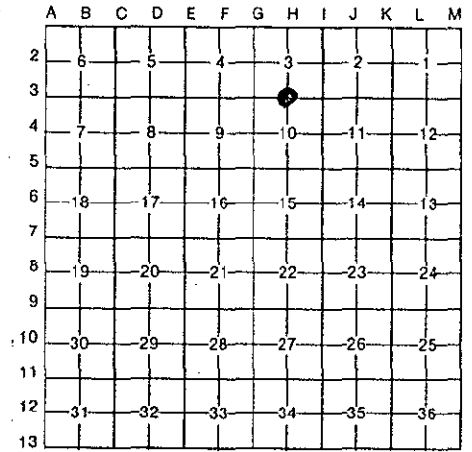

NOTE: Not more than 4 corners, all in the same town and range, may be recorded on this certificate.

A. Description of original monument and accessories and/or subsequent restoration:

1/4 corner between Sections 3 & 10, T 11 N, R 15 W, Dalton Township.

Set post June 24, 1837, by GLO Surveyors

6" W. Oak N 67° E 34 L
13" B. Oak S 65° W 13 L

B. Description of corner evidence found and/or method applied in restoring or reestablishing corner:

Found 3/4" pipe as per Muskegon County Road Commission Witness book.

SW 41.23' 14" Twin Oak
NNE 47.96' 10" Oak
NNE 41.00' 16" Oak
SE 79.40' 14" Oak


POSITION OF SAID
RECORDED CORNER
REVIEWED & RATIFIED
BY MUSKEGON COUNTY
PEER GROUP IN ACCORDANCE
WITH P.A. 345, OF 1990

May 2, 1994

C. Description of monument for corner and accessories established to perpetuate locating the position of the corner:

Set 2 3/4" by 20" Cast Iron Monument with County Surveyor Cap.

N 70° W 41.55' Set nail 12" Oak.
North 13.66' Set nail 20" Oak Stump.
N 25° W 41.90' Set nail 24" Oak.
S 52° W 41.11' Fd. nail 14" Twin Oak.
N 26° E 40.92' Fd. nail 16" Oak.
S 59° E 79.40' Fd. nail 14" Oak.

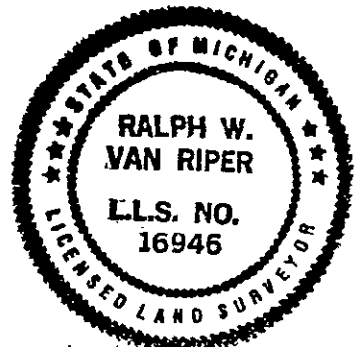

Signed by *Ralph W. VanRiper*

Date 12/27/94

Surveyor's Michigan License No. 16946