

1832

LIB: 1744 434

COMMISSION

LAND CORNER RECORDATION CERTIFICATE
Filing Requirement of Act 74, Mich. P.A. 1970

For corners in

Muskegon
(County)

Located In:

Corner Code #/

1. Public Land Survey	T	11N	R	16W	H	12
	T		R			
	T		R			
	T		R			
2. Property Controlling in Section	S		T		R	
	S		T		R	
3. Miscellaneous Property in Sec.	S		T		R	
	S		T		R	

STATE OF MICHIGAN
COUNTY OF MUSKEGON
REGISTER OF DEEDS
1993 DEC 29 PM 3:09

Register of Deeds Stamp & File Number

- 4. Lot No. _____, Recorded Plat _____
- 5. Private Claims _____

I, Ralph W. VanRiper, in a field survey on June 8, 1993 do hereby certify that under requirements of P.A. 74, Michigan P.A. of 1970, the corner points mentioned in lines 1 and 2 above were in conformance with regulations and rules therefore as required in the current manual of survey instructions of the United States Department of the Interior, Bureau of Land Management or by a decree of a Court of Law and/or that the corner points mentioned in lines 3, 4 and 5 above were in conformance with the rules of the Michigan Board of Land Surveyors or by a Decree of a Court of Law; established, re-established, monumented, re-monumented, recovered, found as expressed below:

NOTE: Not more than 4 corners, all in the same town and range, may be recorded on this certificate.

A	B	C	D	E	F	G	H	I	J	K	L	M
2	6		5		4		3		2		1	
3												
4	7		8		9		10		11		12	
5												
6	18		17		16		15		14		13	
7												
8	19		20		21		22		23		24	
9												
10	30		29		28		27		26		25	
11												
12	31		32		33		34		35		36	
13												

A. Description of original monument and accessories and/or subsequent restoration:

Center of Section 34, T 11 N, R 16 W, Dalton Township
Not set by GLO Surveyors


B. Description of corner evidence found and/or method applied in restoring or reestablishing corner:

Found Concrete Monument as per Muskegon County Road Comm. Witness Book	S 20° E	6.92'	14" Tw. Oak
	N 30° E	30.35'	10" Pine
	NNE	42.29'	24" Oak
Historical usage, documentation and evidence of corner location reviewed and ratified by Muskegon County Peer Group, June 15, 1993	NE	30.22'	10" Pine
	ESE	26.16'	12" Pine
	SE	6.38'	14" Tw. Oak

C. Description of monument for corner and accessories established to perpetuate locating the position of the corner:

Set 2 3/4" by 20" Cast Iron Monument with County Survey Cap

N 23° E	46.23'	Set Spike in 10" Pine
N 52° E	30.21'	Fd. Spike in 14" Pine
S 57° E	26.17'	Fd. Spike in 12" Pine
S 21° E	6.91'	Fd. Spike in 18" Tw. Oak
S 17° E	34.21'	Set Spike in 10" Pine
S 04° E	44.55'	Set Spike in 14" Maple

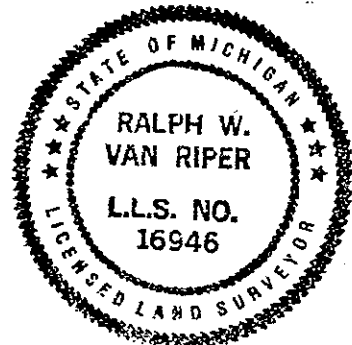

Signed by Ralph W. Van Riper

Date Dec. 28, 1993

Surveyor's Michigan License No. 16946