

**SURVEY &
REMONUMENTATION**

LIBER **1810** PAGE **636**

STATE OF MICHIGAN
COUNTY OF MUSKEGON
RECEIVED FOR RECORD

APR 28 1995

1994 DEC 29 AM 10:19

LAND CORNER RECORDATION CERTIFICATE
Filing Requirement of Act 74, Mich. P.A. 1970

COMMISSION

Carrie Carter
REGISTER OF DEEDS

For corners in
Muskegon

(County)

Located In:

Corner Code #

1. Public Land Survey	T	<u>11N</u>	R	<u>16W</u>	<u>I 2</u>
	T	_____	R	_____	_____
	T	_____	R	_____	_____
	T	_____	R	_____	_____
2. Property Controlling in Section	S	_____	T	_____	R
	S	_____	T	_____	R
3. Miscellaneous Property in Sec.	S	_____	T	_____	R
	S	_____	T	_____	R

A1660

Register of Deeds Stamp & File Number

4. Lot No. _____, Recorded Plat _____
5. Private Claims _____

	A	B	C	D	E	F	G	H	I	J	K	L	M
2	6		5		4		3		2				
3													
4	7		8		9		10		11		12		
5													
6	18		17		16		15		14		13		
7													
8	19		20		21		22		23		24		
9													
10	30		29		28		27		26		25		
11													
12	31		32		33		34		35		36		
13													

I, Ralph W. VanRiper, in a field survey on November 4, 1994, do hereby certify that under requirements of P.A. 74, Michigan P.A. of 1970, the corner points mentioned in lines 1 and 2 above were in conformance with regulations and rules therefore as required in the current manual of survey instructions of the United States Department of the Interior, Bureau of Land Management or by a decree of a Court of Law and/or that the corner points mentioned in lines 3, 4 and 5 above were in conformance with the rules of the Michigan Board of Land Surveyors or by a Decree of a Court of Law; established, re-established, monumented, re-monumented, recovered, found as expressed below:

NOTE: Not more than 4 corners, all in the same town and range, may be recorded on this certificate.

A. Description of original monument and accessories and/or subsequent restoration:

1/4 Corner between Sections 2 and 3, T 11 N, R 16 W
Dalton Township

Set post June 22, 1837, by GLO Surveyors

6" Oak S 21° E 62 L
20" Oak N 47° E 23 L

B. Description of corner evidence found and/or method applied in restoring or reestablishing corner:

Found "T" Iron in Monument Box as per Muskegon County Road Commission Witness book, recorded by Stanley Shackelford, LLS No. 30100, Jan. 15, 1988, Liber 1422, Page 03

SE 10" TW Oak 63.45'
NE 10" B. Oak 54.00'
SW P. Pole 34.96'
NW U.S.G.S. 36.65'


POSITION OF SAID
RECORDED CORNER
REVIEWED & RATIFIED
BY MUSKEGON COUNTY
PEER GROUP IN ACCORDANCE
WITH P. L. 345, OF 1930

May 2, 1994 SW

C. Description of monument for corner and accessories established to perpetuate locating the position of the corner:

Set 2 3/4" Cast Iron Monument with County Survey
Cap in Monument Box.

N 38° E 77.24' Set nail in 12" Oak
S 45° E 63.45' Fd. nail in 10" Tw. Oak
N 55° E 54.00' Fd. nail in 10" B. Oak
S 40° E 47.00' Fd. Concrete Monument
N 55° W 36.65' Fd. U.S.G.S Conc. B.M.
S 45° W 34.96' Fd. nail in Power Pole

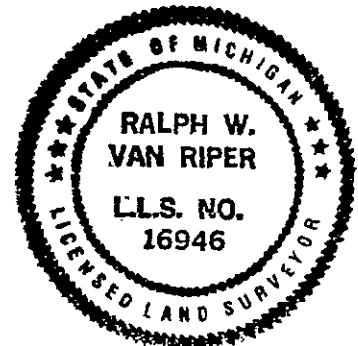

Signed by *Ralph W. Van Riper*

Date 12/27/94

Surveyor's Michigan License No. 16946