

**SURVEY &
REMONUMENTATION**

LIBER **1810** PAGE **637**

STATE OF MICHIGAN
COUNTY OF MUSKEGON
RECEIVED FOR RECORD

APR 28 1995

1994 DEC 29 AM 10:19

COMMISSION

LAND CORNER RECORDATION CERTIFICATE
Filing Requirement of Act 74, Mich. P.A. 1970

Carrie Carter
REGISTER OF DEEDS

For corners in
Muskegon
(County)

Located In:

Corner Code ##

1. Public Land Survey	T	11N	R	16W	I 3
	T		R		
	T		R		
	T		R		
2. Property Controlling in Section	S		T	R	
	S		T	R	
3. Miscellaneous Property in Sec.	S		T	R	
	S		T	R	

A1661

Register of Deeds Stamp & File Number

4. Lot No. _____, Recorded Plat _____
5. Private Claims _____

	A	B	C	D	E	F	G	H	I	J	K	L	M
2	6	5	4	3	2	1							
3									●				
4	7	8	9	10	11	12							
5													
6	18	17	16	15	14	13							
7													
8	19	20	21	22	23	24							
9													
10	30	29	28	27	26	25							
11													
12	31	32	33	34	35	36							
13													

I, Ralph W. VanRiper, in a field survey on November 4, 1994, do hereby certify that under requirements of P.A. 74, Michigan P.A. of 1970, the corner points mentioned in lines 1 and 2 above were in conformance with regulations and rules therefore as required in the current manual of survey instructions of the United States Department of the Interior, Bureau of Land Management or by a decree of a Court of Law and/or that the corner points mentioned in lines 3, 4 and 5 above were in conformance with the rules of the Michigan Board of Land Surveyors or by a Decree of a Court of Law; established, re-established, monumented, re-monumented, recovered, found as expressed below:

NOTE: Not more than 4 corners, all in the same town and range, may be recorded on this certificate.

A. Description of original monument and accessories and/or subsequent restoration:

Section corner between Sections 2, 3, 10 and 11,
T 11 N, R 16 W, Dalton Township


Set post, June 22, 1837, by GLO Surveyors

- 28" Pine S 32° E 53 L
- 26" Pine N 80° W 61 L

B. Description of corner evidence found and/or method applied in restoring or reestablishing corner:

Found Boat Spike in ASP as per Muskegon County Road Commission Witness Book, recorded by Stanley Shackelford, LLS No. 30100, Liber 1422, Page 03, Jan. 15, 1988

- NE 30" Oak 61.85'
- NW P. Pole 54.00'
- WNW 12" Oak 66.62'
- SE 10" Oak 65.85'

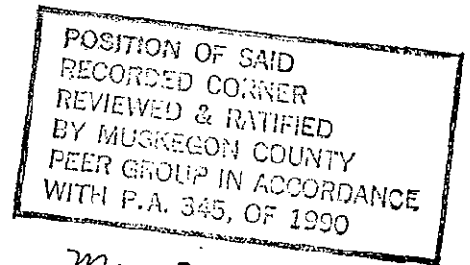

May 2, 1994 su

C. Description of monument for corner and accessories established to perpetuate locating the position of the corner:

Set 2 3/4" Cast Iron Monument with County Survey Cap

- N 62° E 61.85' Fd. nail in 30" Oak
- N 35° W 52.93' Set nail in Power Pole
- N 76° W 66.39' Fd. nail in 12" Oak
- S 41° E 65.81' Fd. nail in 10" Oak
- N 78° E 30.98' Set nail in 12" Oak
- N 34° E 55.45' Set nail in Power Pole



Signed by *Ralph W. Van Riper* Date 12/27/94
Surveyor's Michigan License No. 16946